


T.16S., R.14E., W.M.

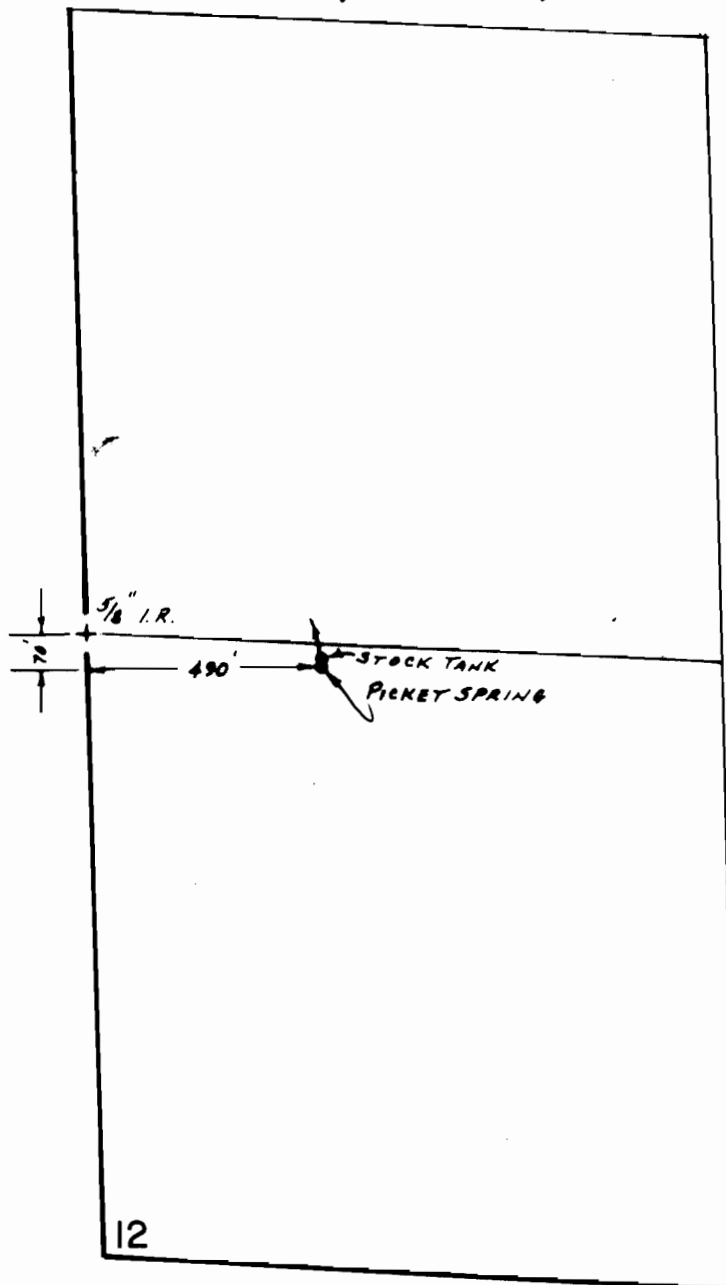

SCALE: 1" = 400'

**FINAL PROOF SURVEY**  
**UNDER**

Application No. ~~57808~~ Permit No. 43522....  
**IN NAME OF**

.....**ROBERT D. RICHTER**.....

Surveyed Oct. 9.... 1990, by R.W. BISHOP....