


T. 7 S. R. 3 9 E. W. M.

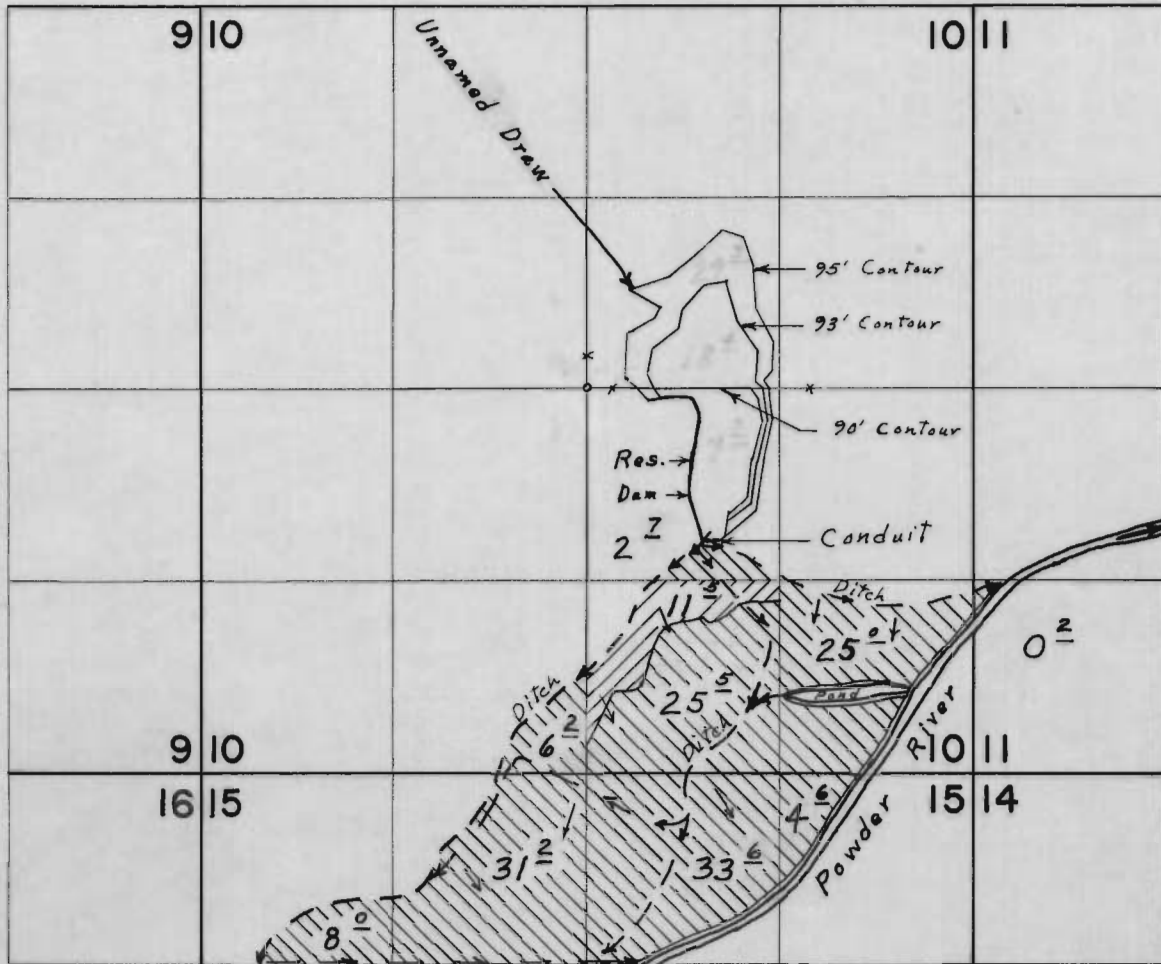

Div. Pt. located 1040' S. & 800' E. from center Section 10

FINAL PROOF SURVEY

UNDER

59560

44618

R-58190

R- 7983

R-44814

R- 5295

Application No. 44815 Permit No. 33518

IN NAME OF

MARION C. INMAN

Surveyed May 16, 1970, by L. E. Gould