


T. 2 S., R. 37 E., W.M.

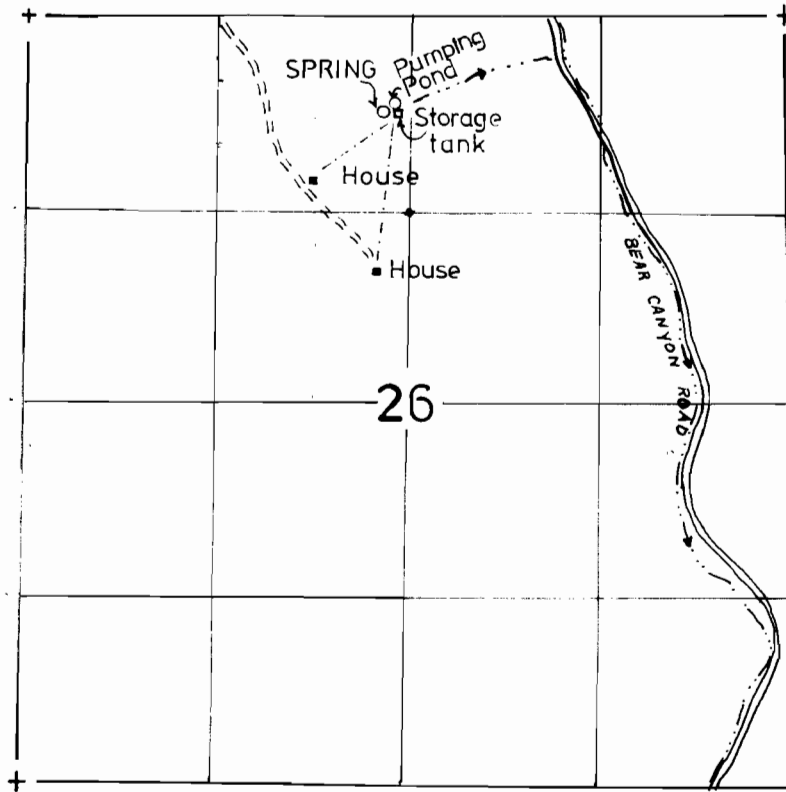

POD SPRING - 660' N. AND 240' W. FROM THE SE COR.
OF NE 1/4 NW 1/4.

FINAL PROOF SURVEY
UNDER

Application No. 59920 Permit No. 45676
IN NAME OF

RAY L. AND BEATRICE HEDDEN AND GARY L. AND NANCY HEDDEN

Surveyed 7-7, 1993, by J. MILLER