


T.2N. R.40E.,W.M.

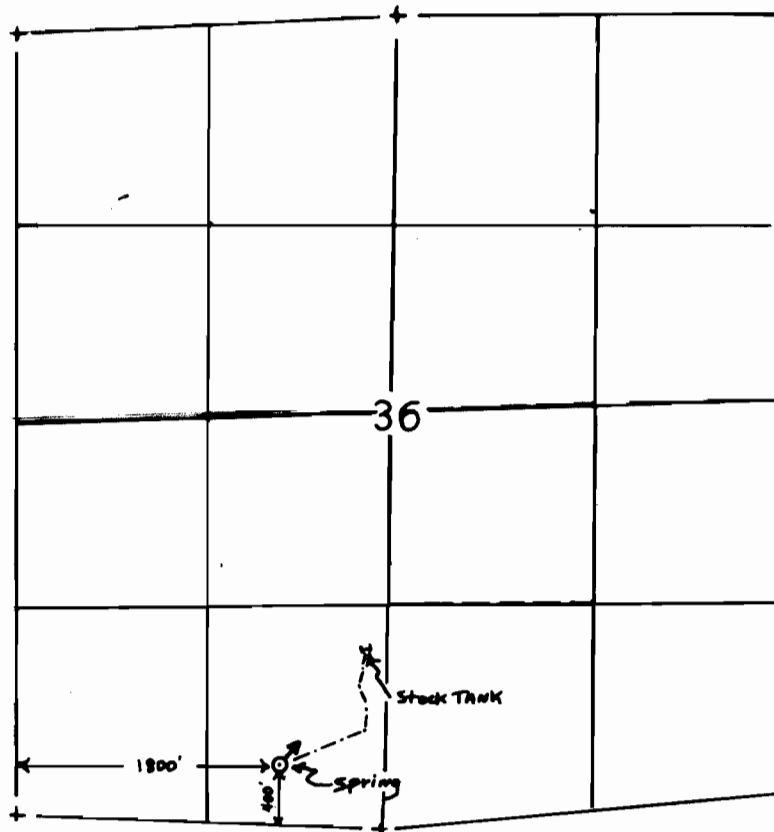

1" = 1320'

FINAL PROOF SURVEY
UNDER

Application No. 68228. Permit No. 49148.....
IN NAME OF

.....R.K. WALLER.....

Surveyed ..3-20.. 1991.., by K.KEMP.....