


T.13 S., R.20 E. W.M.

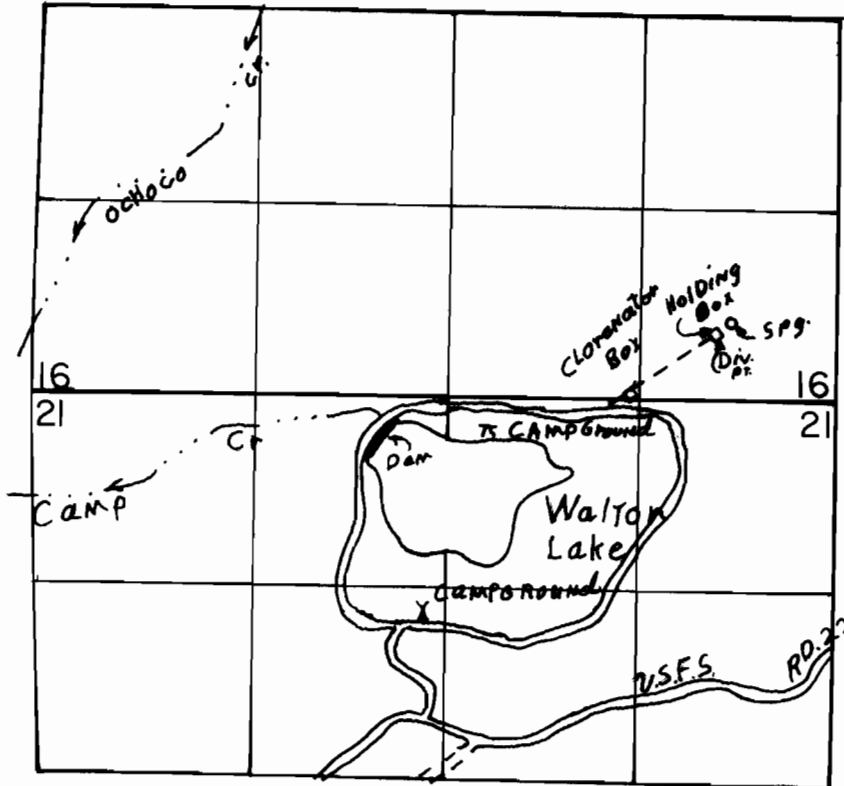

DIV. PT. LOC: 400' N & 840' W FROM SE COR. OF SEC 16.

SCALE: 1" = 1320'

FINAL PROOF SURVEY UNDER

Application No. 66419. Permit No. 51293.....
IN NAME OF

UNITED STATES, OCHOCHO NAT. FOREST

Surveyed JULY 19 1995., by R.M. SUTTERFIELD