

TOLLGATE WATER COMPANY FINAL PROOF FOR GROUND WATER PERMIT

Sec. 31, T.14S., R.10E., W.M.,
and Sec. 5, T.15S., R.10E., W.M.,
Deschutes County, Oregon

APPLICATION NO. G-12875
PERMIT NO. G-12339

RECEIVED

JUL 17 1998

WATER RESOURCES DEPT.
SALEM, OREGON

RECEIVED

JUL 17 1998

WATER RESOURCES DEPT.
SALEM, OREGON

31			31 32
	WELL #1 ○		
31			31 32
6			6 ○ WELL #2 5 NW1/4NW1/4




T.14 S.

T.15 S.

WELL #1 LOCATED 2327' N. & 2560 E. FROM SW CORNER SECTION 31.
WELL #2 LOCATED 150' S. & 150' E. FROM NW CORNER SECTION 5.

I, James R. Tye, Certified Water Right Examiner in the State of Oregon, hereby certify that this water rights survey map was prepared under my direct supervision.

The preparation of this map is for the purpose of identifying the location of the water right only and has no intent to provide dimensions or locations of property ownership lines.

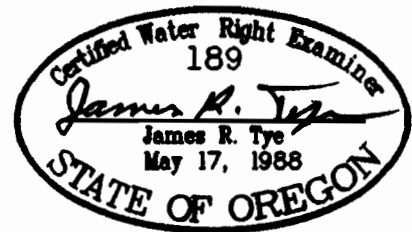

SCALE 1"=1320' | DATE 7-10-98 | SURVEY BY J.T. | DRAWN BY S.R.K. | ORDER NO. 4517-22A

SUN COUNTRY ENGINEERING & SURVEYING, INC.
920 S.E. ARMOUR ROAD BEND, OREGON 97702 PHONE 382-8882