
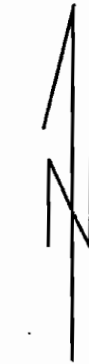



T. 19 S., R. 33 E., W. M.

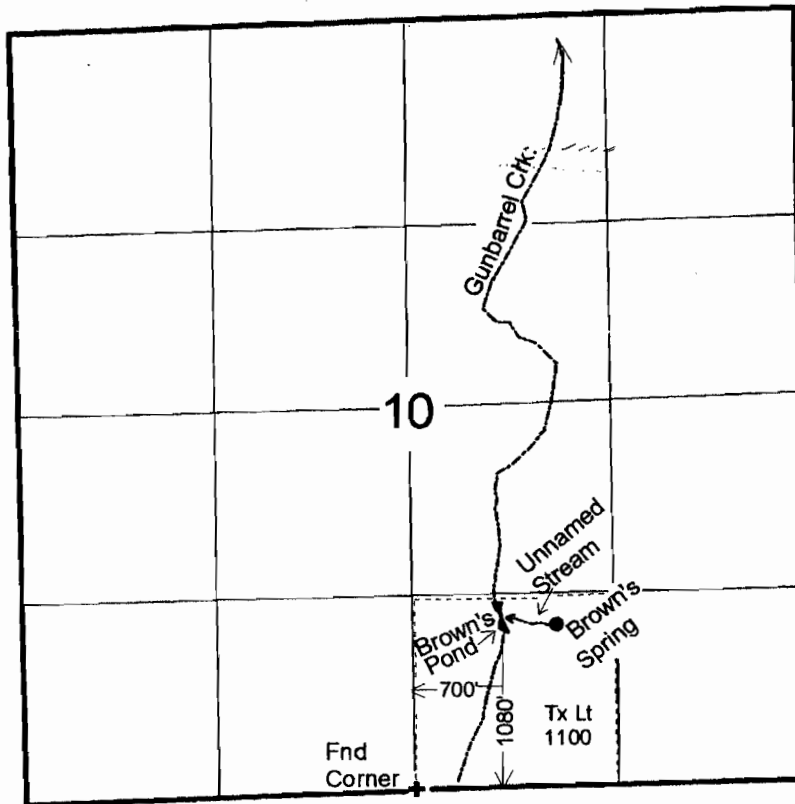

1" = 1320'

FINAL PROOF MAP  
under  
Application R-86138 Permit R-14191

IN THE NAMES OF  
MARY ELLEN BROWN  
and  
JUDITH E. KRUTSCH

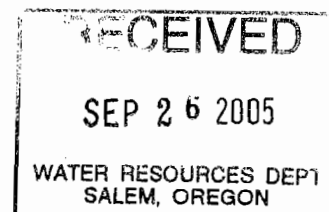

09/13/2005 JM