
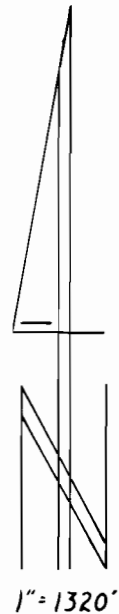


T. 18 S., R. 8 W., W.M.

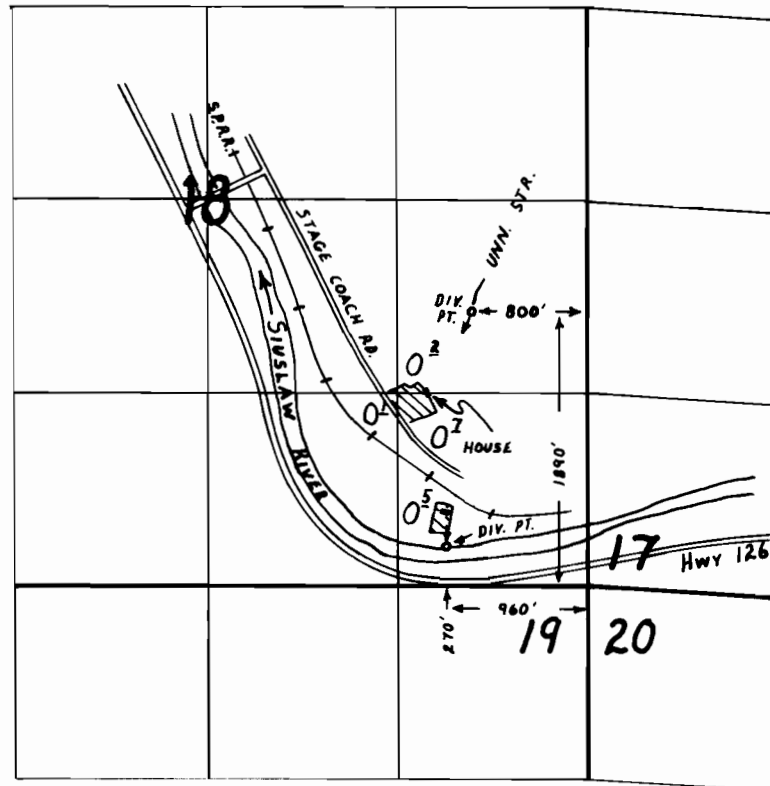

FINAL PROOF SURVEY

UNDER

Application No. 63498 Permit No. 47361

IN NAME OF

BONNIE C. SMITH

Surveyed MAY 20, 1992, by R.W. Klassen