




T. 3 S., R. 9 W., W.M.

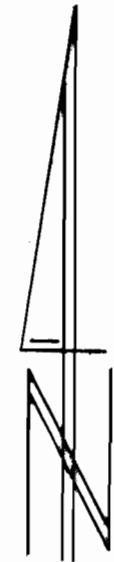

1" = 1320'

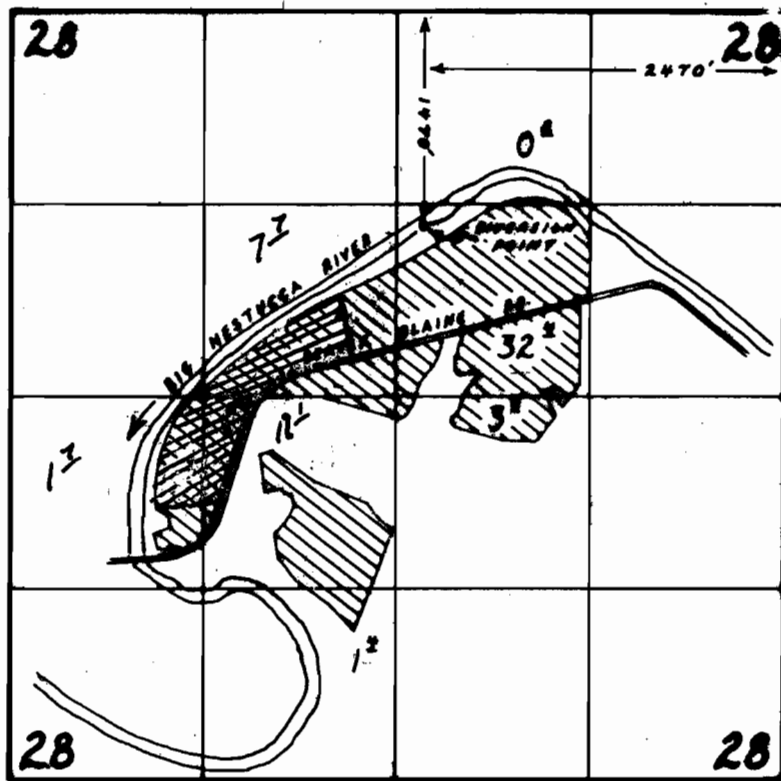

PERMIT
45775

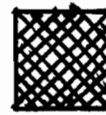

CERTIFICATE
12147

FINAL PROOF SURVEY

UNDER

Application No. 61712 Permit No. 45775
IN NAME OF

A.W. Marcum

Surveyed July 21, 1993, by R.W. Klassen