
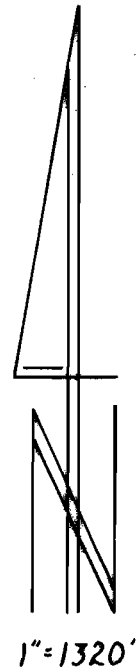


T. 18 S., R. 7 W., W.M.

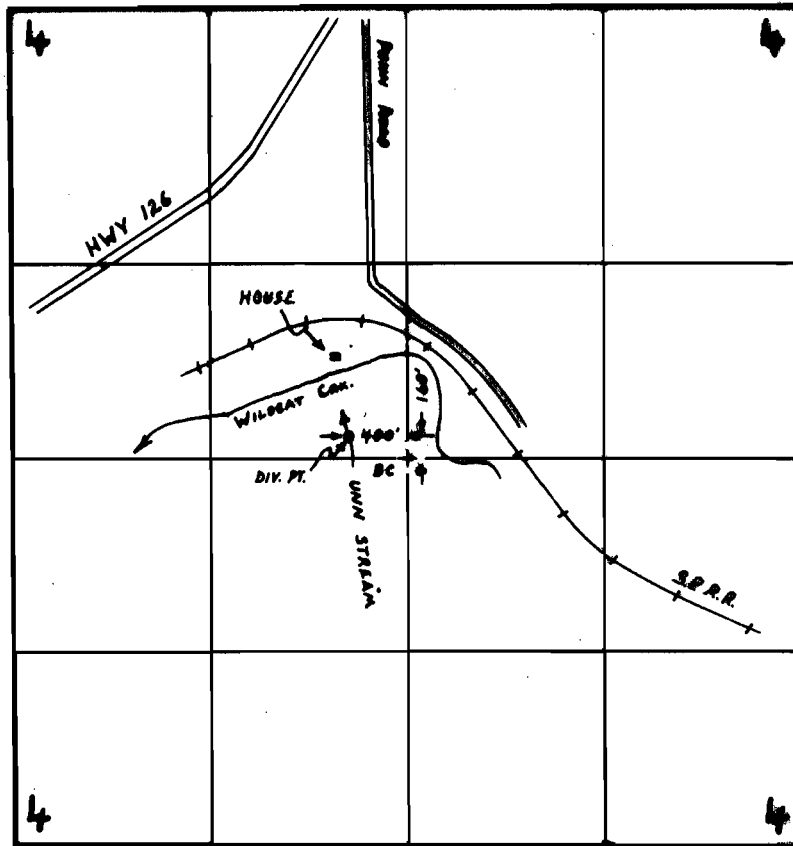

FINAL PROOF SURVEY
UNDER

Application No. 51705 Permit No. 38979
IN NAME OF

KERMIT H. CARLILE

Surveyed MAY 20, 1992, by R.W. Klassen