
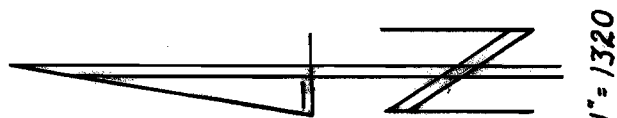


# T. 6 & 7 S., R. 9 & 10 W., W.M.

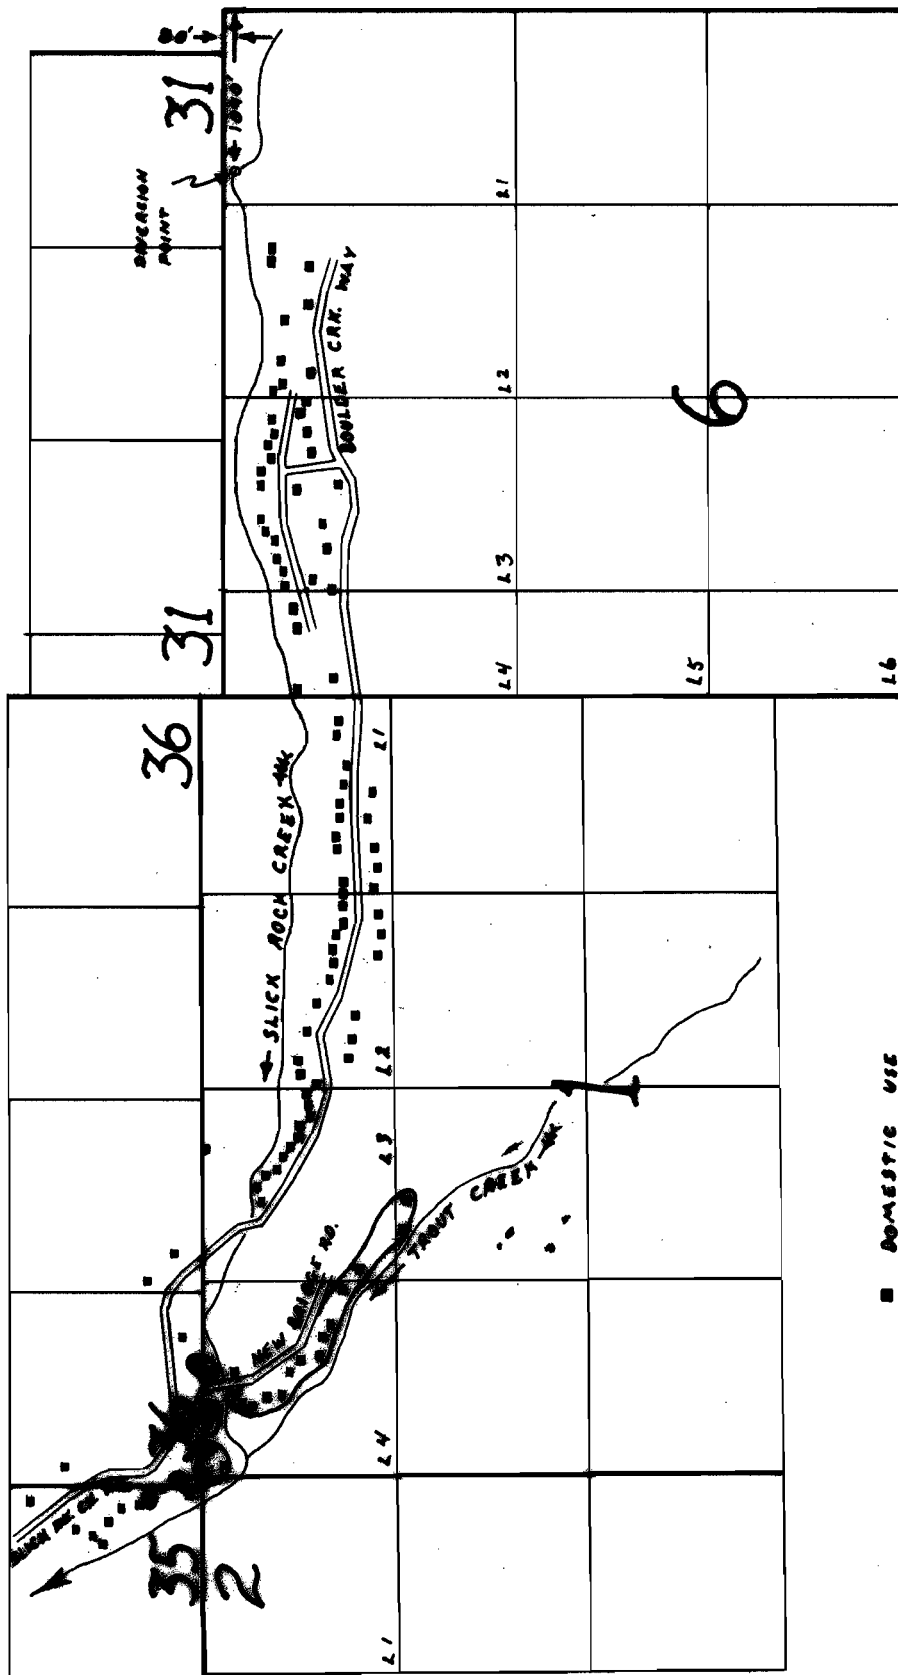

## FINAL PROOF SURVEY

UNDER

Application No. 49566 Permit No. 36090  
IN NAME OF

Rose Lodge Water Company

Surveyed May 11, 1994, by R.W. Klassen