


T. 2 S., R. 5 W., W.M.

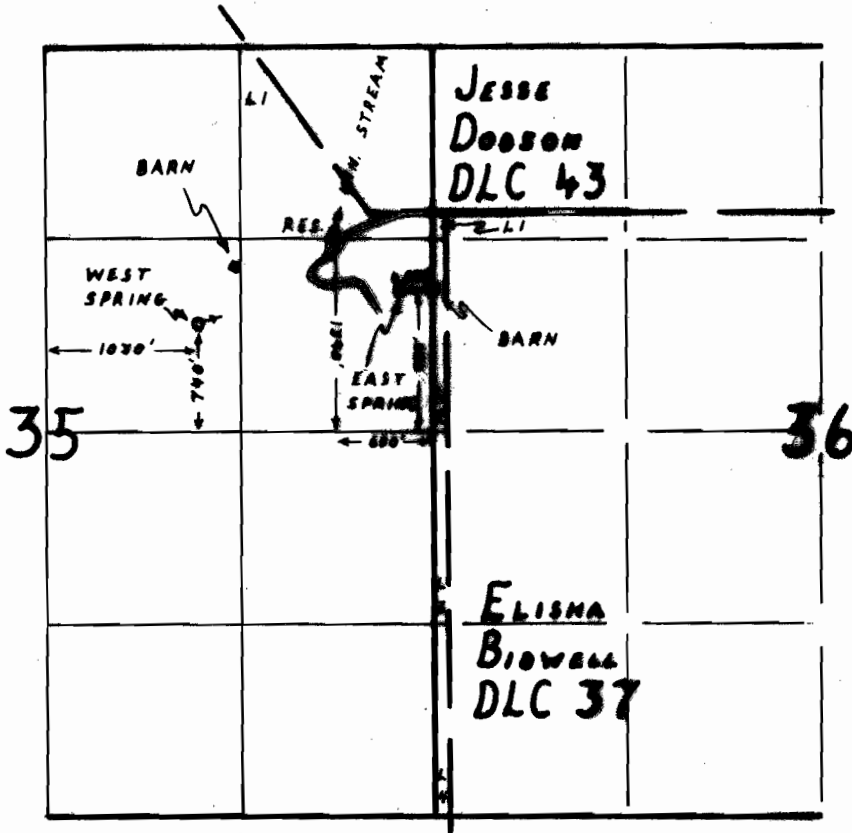

FINAL PROOF SURVEY

UNDER

Application No. R-49918, 49141 Permit No. R-5996, 36848
IN NAME OF

Robert L. Crane

Surveyed June 9, 1993, by R.W. Klassen