
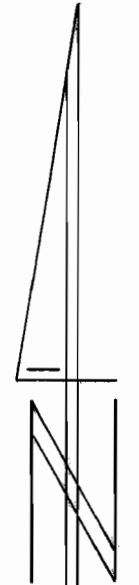


**T. 2 S., R. 5 W., W.M.**

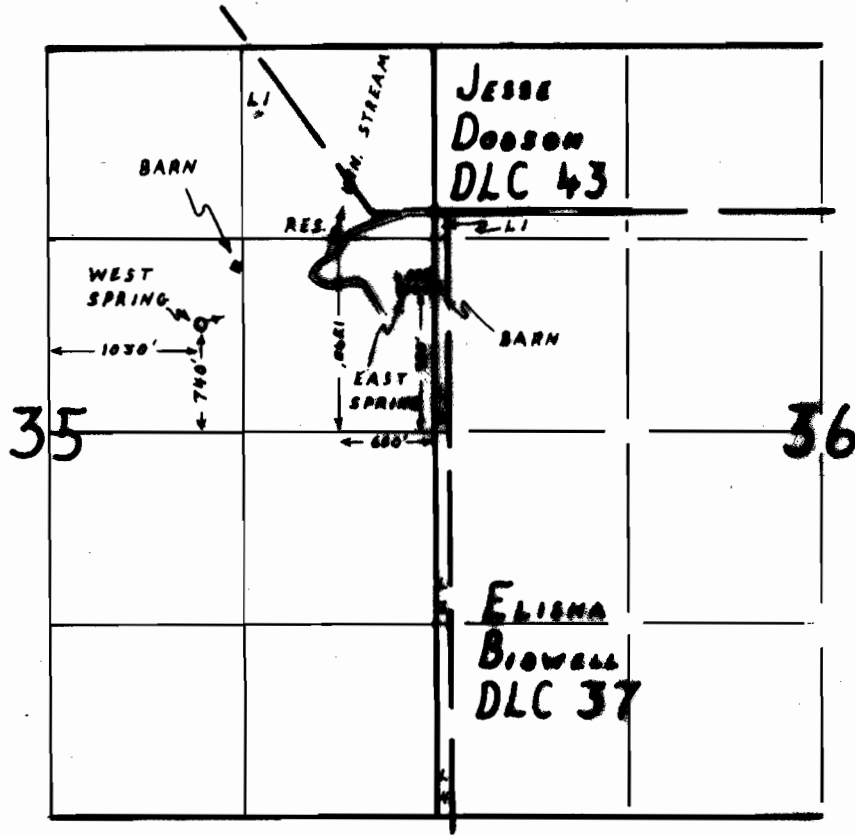

1" = 1320'

**FINAL PROOF SURVEY**

UNDER

Application No. R-49918, 49141 Permit No. R-5996, 36848  
IN NAME OF

Robert L. Crane

Surveyed June 9, 1993, by R.W. Klassen