BURGE IRRIGATION WORKS

T. 10 S. R's. 4 & 5 W.
BENTON COUNTY, OREGON
Scale: 1 inch = 2640 feet

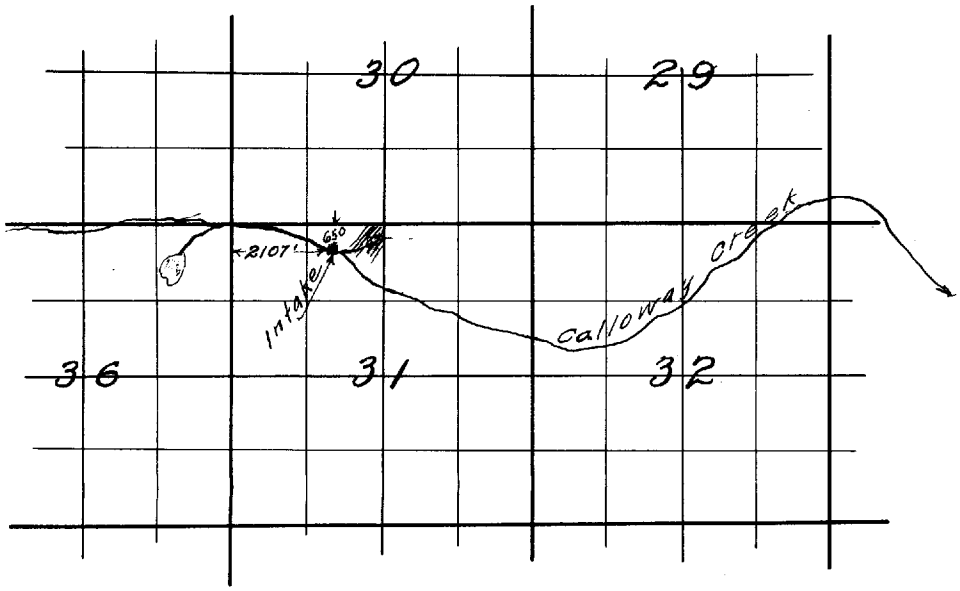

Certificate:-

I, Walter W. Larsen of Corvallis, Oregon, do hereby certify that this map was made from notes taken under my direction on July 13, 1926, and that it correctly represents the works described in the accompanying application together with the location of streams and other ditches in the immediate vicinity

Walter W. Larsen
Registered Professional Engineer
Oregon No 1261

May 1923

ENGINEER
ENGROSSED
OREGON

Application No. ~~10345~~ 10884
Permit No. P. 7444