


T. 2N., R. 13E., W.M.

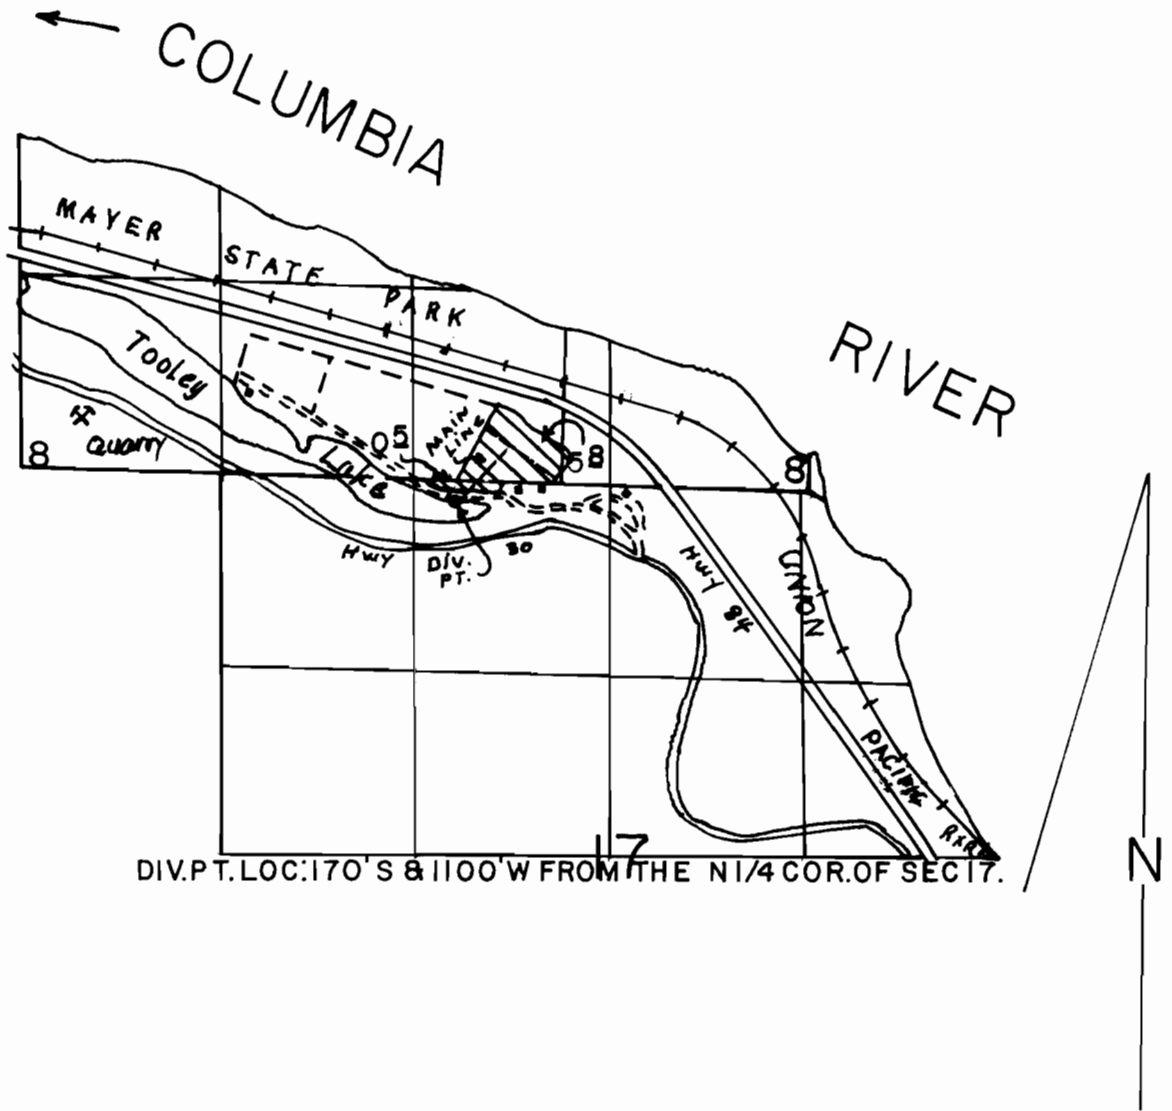

SCALE: 1" = 1320'

FINAL PROOF SURVEY
UNDER

Application No. 68974. Permit No. 49935....
IN NAME OF

.....STEVEN E. BALDWIN.....

Surveyed MAY 22, 1995, by K. STARNES....