


T.2&3N,R.12E,WM.

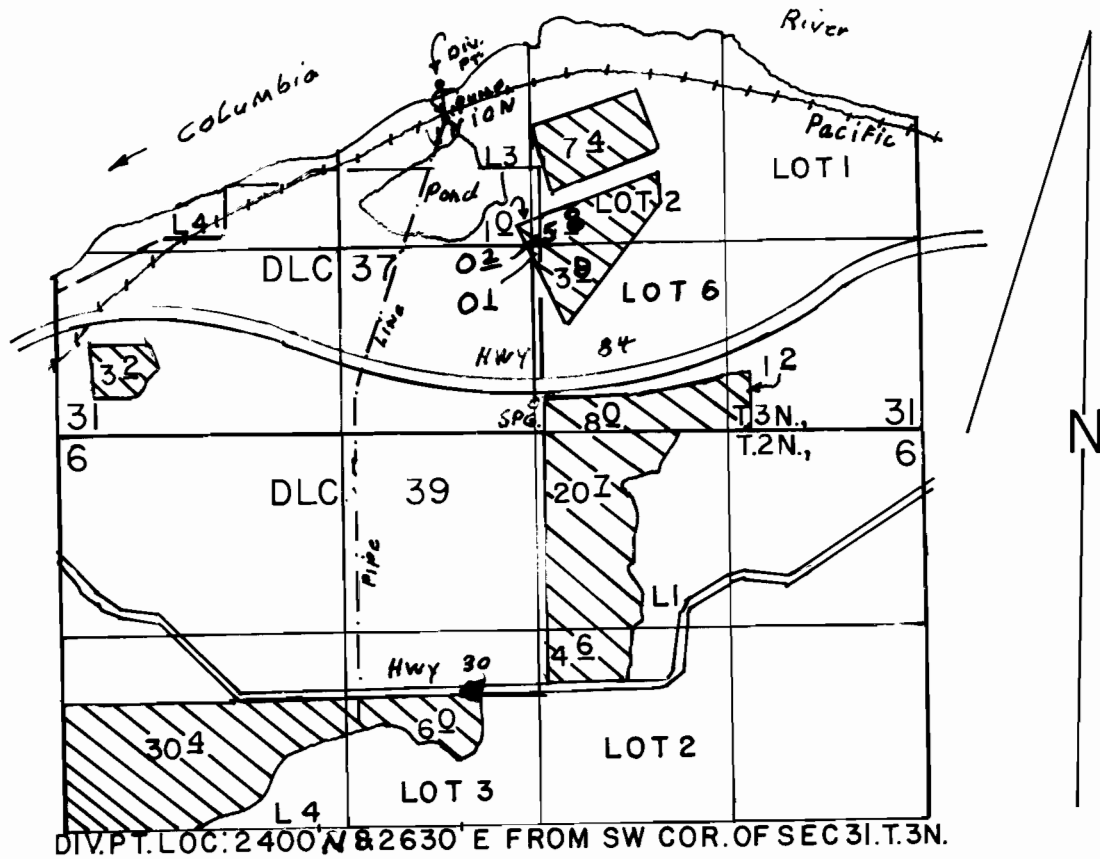

SCALE: 1" = 1320'

**FINAL PROOF SURVEY  
UNDER**

Application No. 68813 Permit No. 49906  
IN NAME OF

.....COLUMBIA.....VIEW.....ORCHARDS...

Surveyed APRIL 25 1995, by R.M.SUTTERFIELD