


# T.1N. R.14E., W.M.

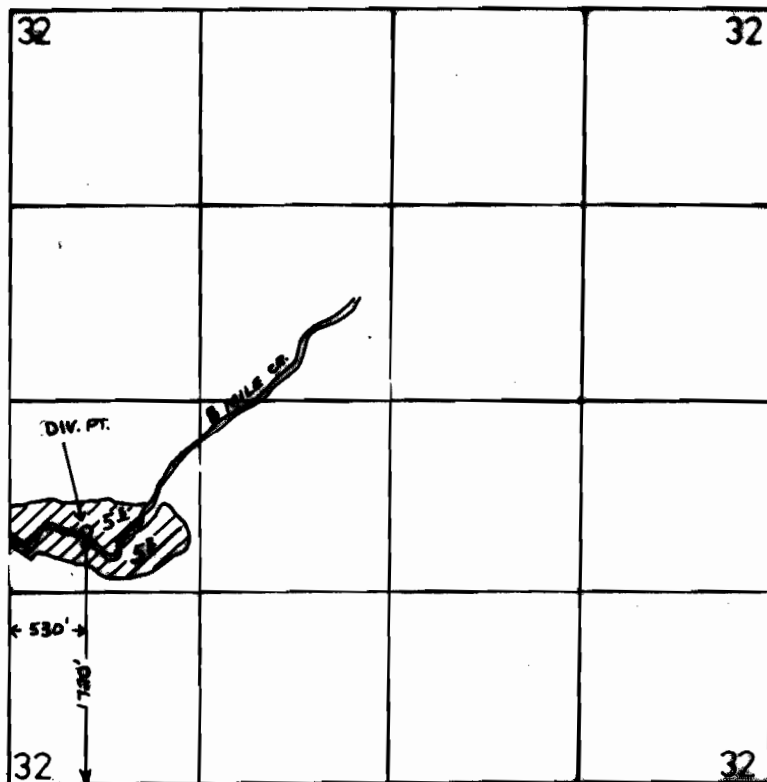

1"=1320'



## FINAL PROOF SURVEY UNDER

Application No. 63169.. Permit No. 4727A.....  
IN NAME OF

..... PEGGY A. GERKING .....

Surveyed 2-6..... 1992., by J. MILLER.....