


T.4S.,R.14E.,W.M.

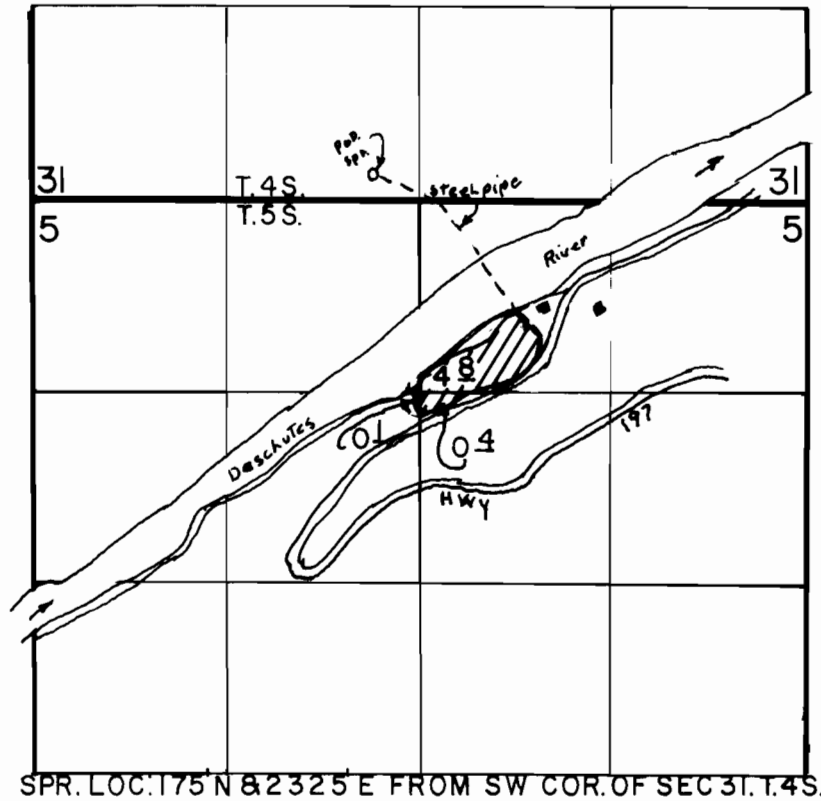

SCALE: 1"=1320'

FINAL PROOF SURVEY
UNDER

Application No. 680.44 Permit No. 48.4.4.5...
IN NAME OF

MICHAEL V. & GLORIA J. MCLUCAS

Surveyed AUG 14, 1995, by R.M. SUTTERFIELD