
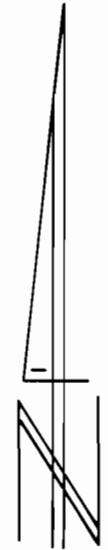


T. 16 S., R. 3 E., W.M.

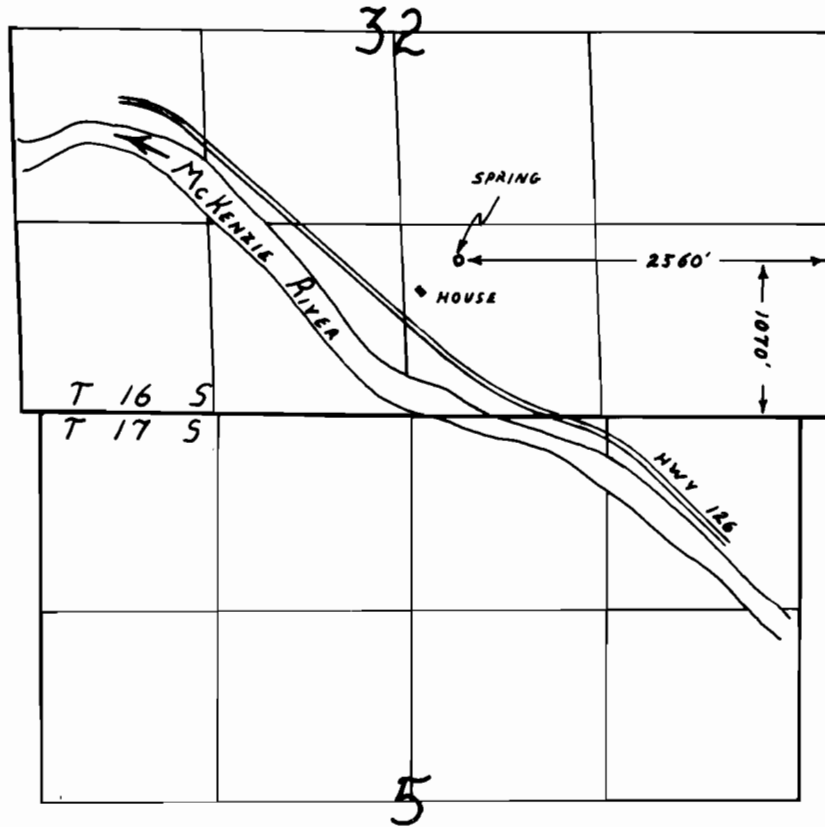

1" = 1320'

FINAL PROOF SURVEY

UNDER

Application No. 58379 Permit No. 43997
IN NAME OF

Anthony F. Baechler

Surveyed November 17, 1992, by R.W. Klassen