


**T. 2 N., R. 10 E., W.M.**

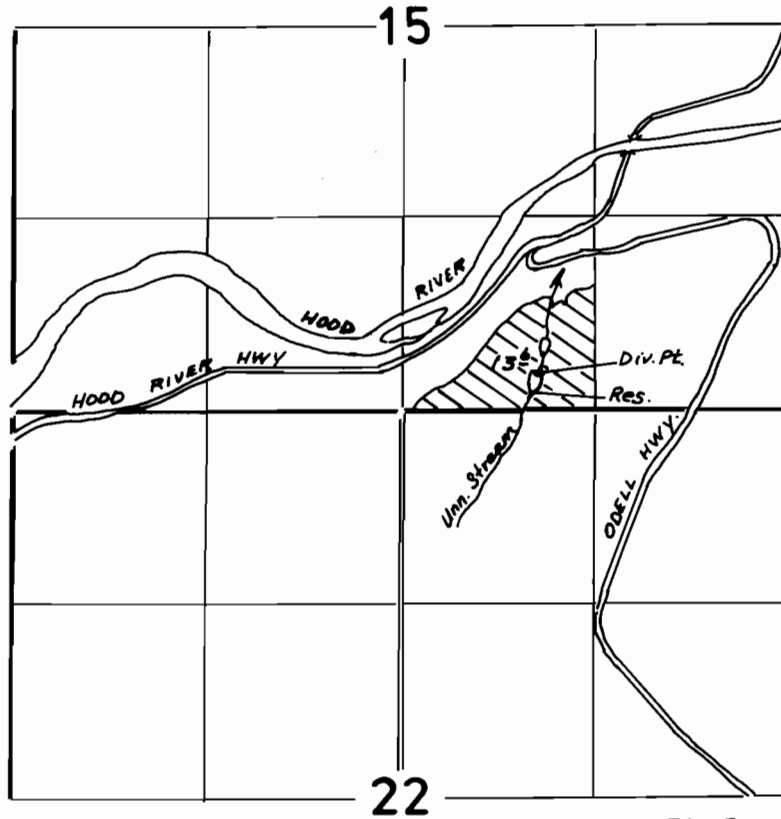

DIV. PT. 250' N. & 930' E. FROM THE S 1/4 COR. SEC. 15.

**FINAL PROOF SURVEY**

UNDER

Application No. R-61455 Permit No. R-8252  
61263 45643

IN NAME OF

FRED ELWOOD MOE

Surveyed SEPTEMBER 30, 1993, by J. MILLER