


T. 2 N., R. 7 E., W.M.

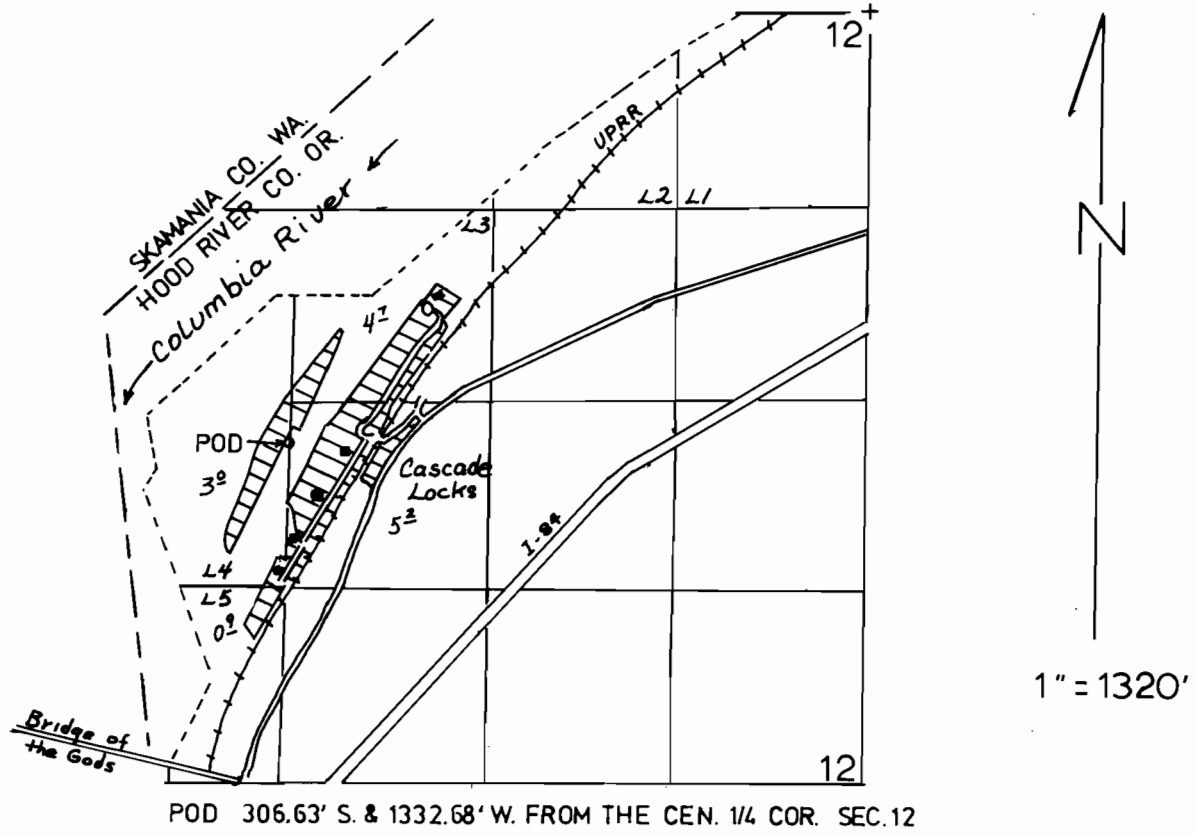

FINAL PROOF SURVEY UNDER

Application No. 58948 Permit No. 45203
IN NAME OF

PORT OF CASCADE LOCKS

Surveyed JULY 22, 1993, by J. MILLER