


# T1N, R.13E, WM.

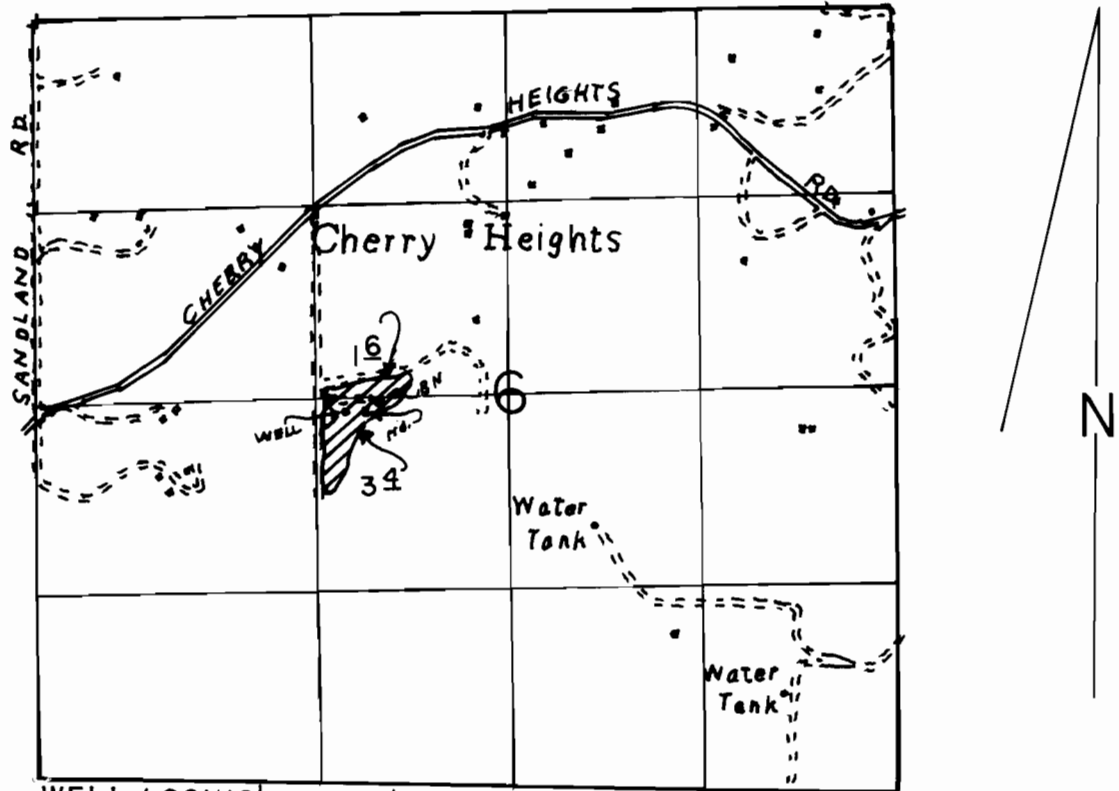

~~WELL LOC: 110' S & 200' E FROM NW COR. OF SEC. 6.~~  
WELL LOC: 110' S & 2110' E FROM W 1/4 COR. OF SEC 6. J.W.G.

SCALE: 1" = 1320'

## FINAL PROOF SURVEY UNDER

Application No. G-10653 Permit No. G-9757....  
IN NAME OF

.....JOHN P. AYRES.....

Surveyed MAY 25 1995, by R.M. SUTTERFIELD