


T 5 S., R. 12 E., W. M.

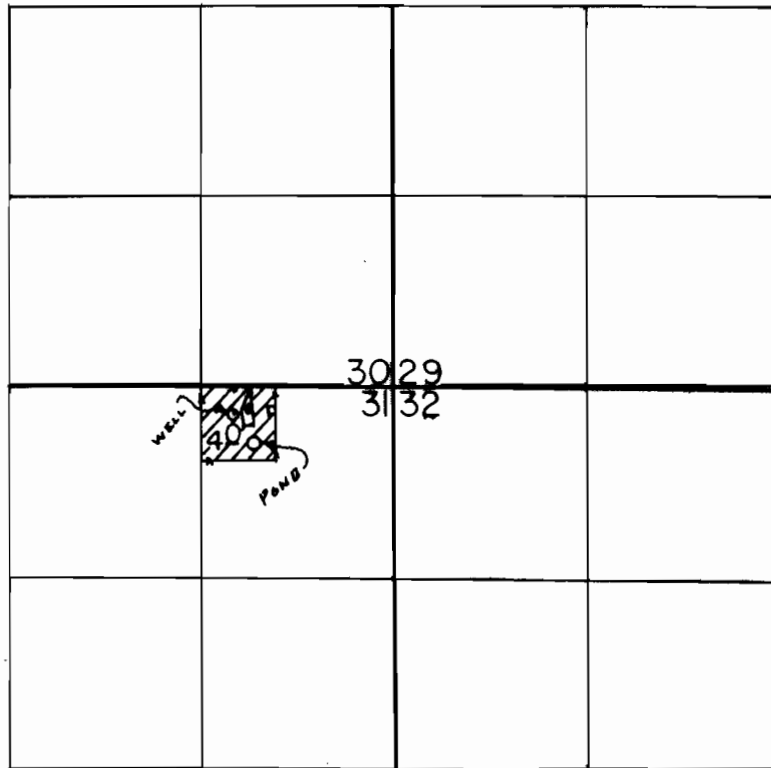

WELL LOC: 170' S & 1100' W FROM NE COR. OF SEC 31.

SCALE: 1" = 1320'

FINAL PROOF SURVEY  
UNDER

Application No. G-10415 Permit No G-9417

IN NAME OF

DONALD J. & MARY A. HAUSINGER

Surveyed AUG 31 19 95, by R.M. SUTTERFIELD