


T.2N.,R.12E.,W.M.

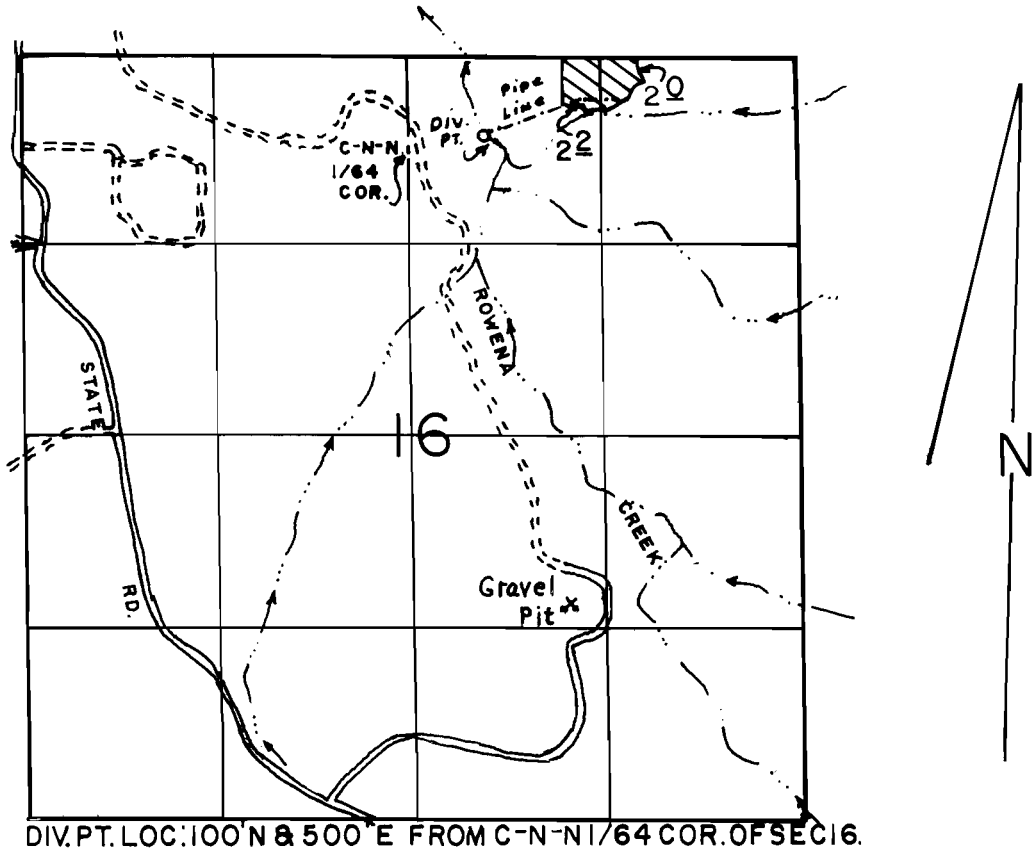

SCALE: 1" = 1320'

**FINAL PROOF SURVEY  
UNDER**

Application No. 65350 Permit No. 47944  
IN NAME OF

.....STEVEN R. BRYAN I.....

Surveyed MAY. 3... 1995, by R.M. SUTTERFIELD