


T.2N.,R.8E.,WM.

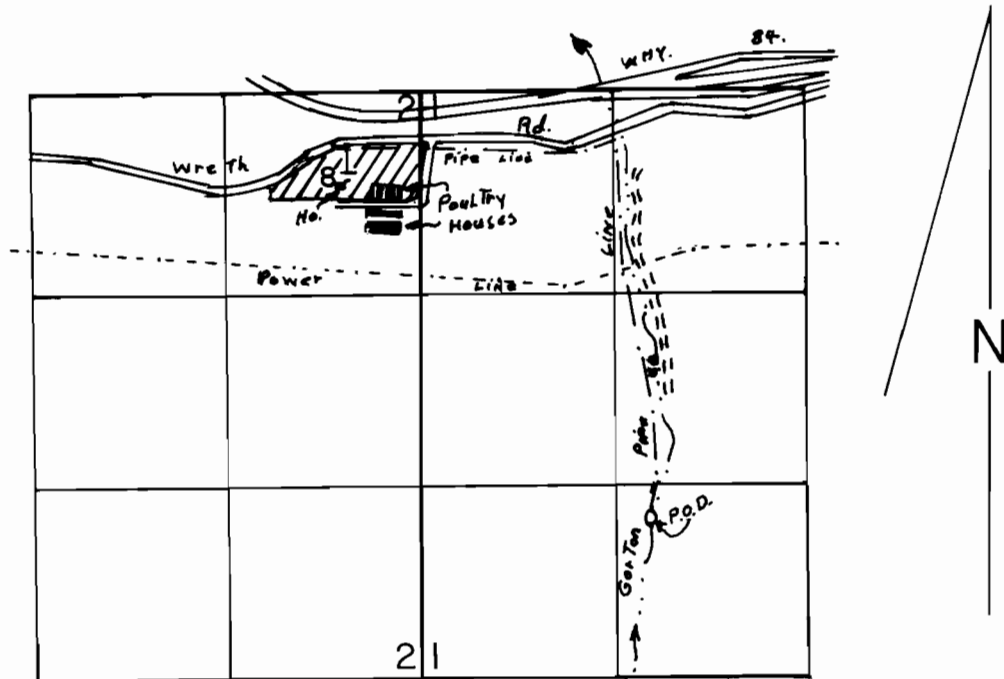

POD. LOC: 1100' N & 1560' E FROM SW COR. OF SEC 1.

SCALE: 1" = 1320'

FINAL PROOF SURVEY UNDER

Application No. 64779. Permit No. 47524.....
IN NAME OF

ROGER A. FOX AND ILONA S. FOX.....

Surveyed AUG 16 1995, by R.M. SUTTERFIELD.....