


T6S, R13&14E, WM.

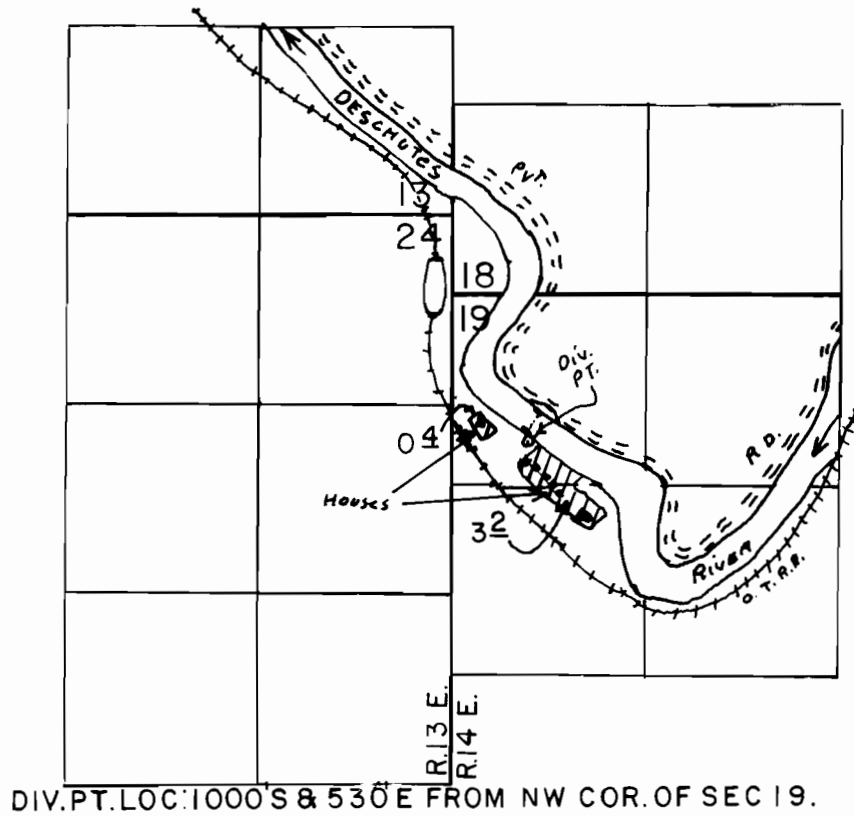

FINAL PROOF SURVEY
UNDER

Application No. 64953 Permit No. 47507...
IN NAME OF

DESCHUTES HOME OWNERS ASSN.

Surveyed AUG 4, 1995, by R.M. SUTTERFIELD.