


T.2N.,R.10E.,W.M.

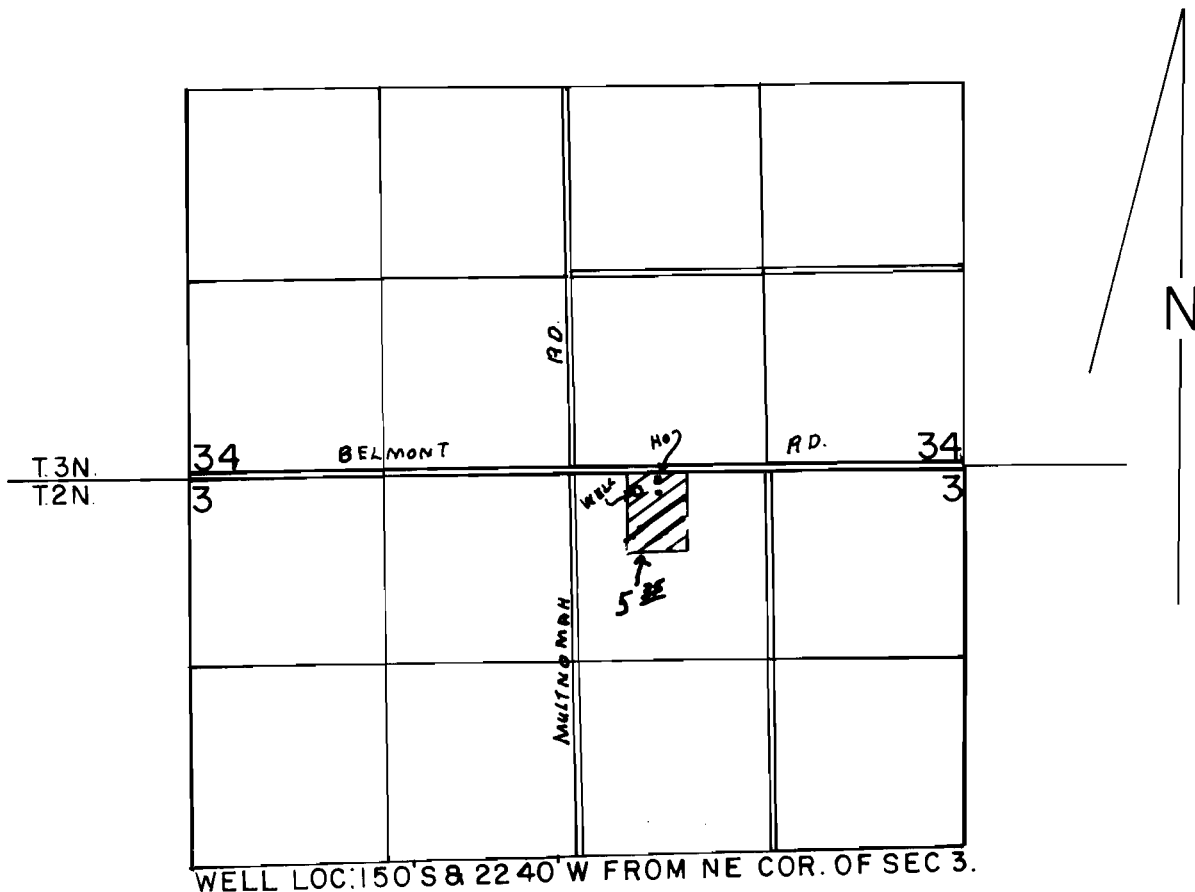

SCALE: 1" = 1320'

**FINAL PROOF SURVEY
UNDER**

Application No. G-11263 Permit No. G-10612...
IN NAME OF

.....CHARLES W. SCOTT.....

Surveyed AUG 16. 19.95, by R.M.SUTTERFIELD