


T.1N.,R.13E.,W.M.

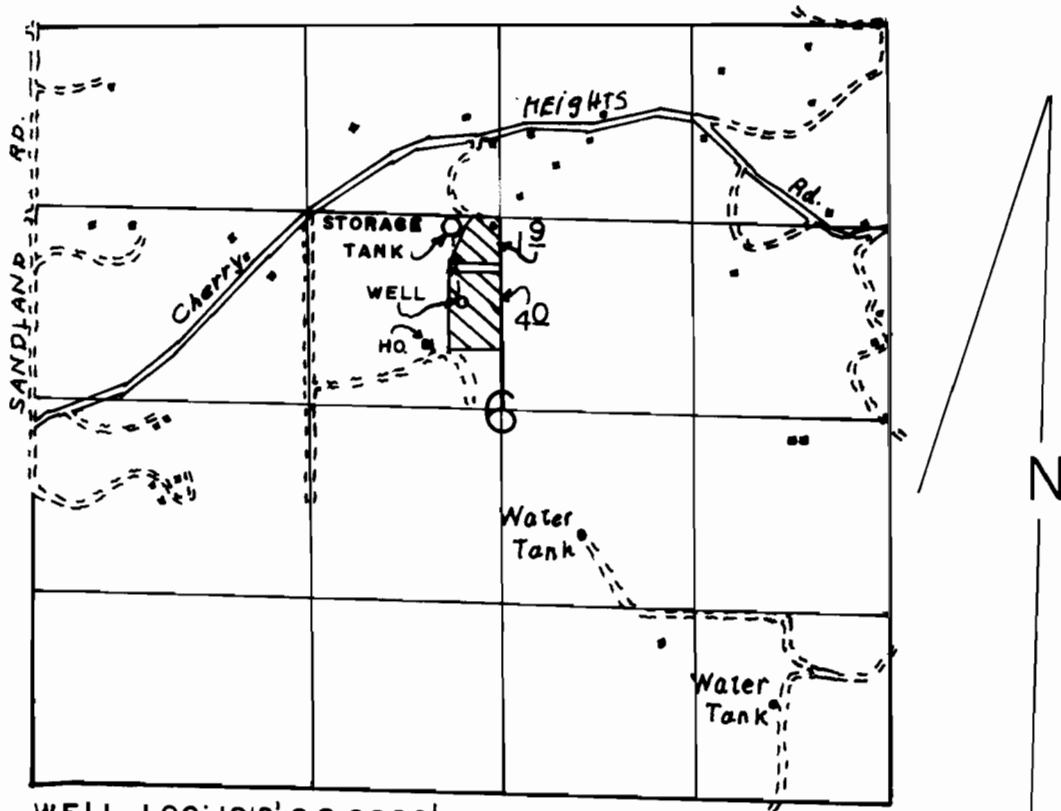

WELL LOC: 1910' S & 2920' W FROM NE COR. OF SEC 6.

SCALE: 1" = 1320'

FINAL PROOF SURVEY
UNDER

Application No. G-11485 Permit No. G-10616...
IN NAME OF

EARL P. AYRES

Surveyed MAY 15, 1995, by R.M. SUTTERFIELD