


T24 S, R 33 E, WM

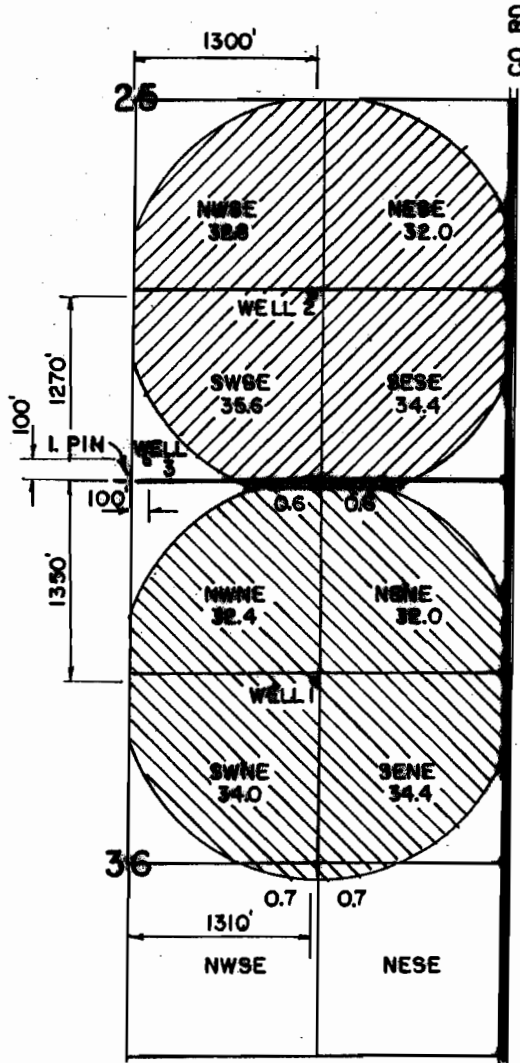

TAX LOT 6902
TAX LOT 6903

RECEIVED
JUN 05 2006
WATER RESOURCES DEPT
SALEM, OREGON

FINAL PROOF SURVEY

UNDER
1-9670

IN THE NAME OF
THOMAS AND BARBARA HOWARD

Scale: 4" = 1 MILE
Dsn:
Drm: CHRIS
Ckd:

Date: JUNE 2006

 M.A. PALMER & SONS, INC.
 ENGINEERING & SURVEYING
 711 Ponderosa Village • Box 61
 Burns, Oregon 97720

Job: 2177-06
Sht. No.
of 1