


# T. 25 & 26 S., R. 14 & 15 E., W.M.

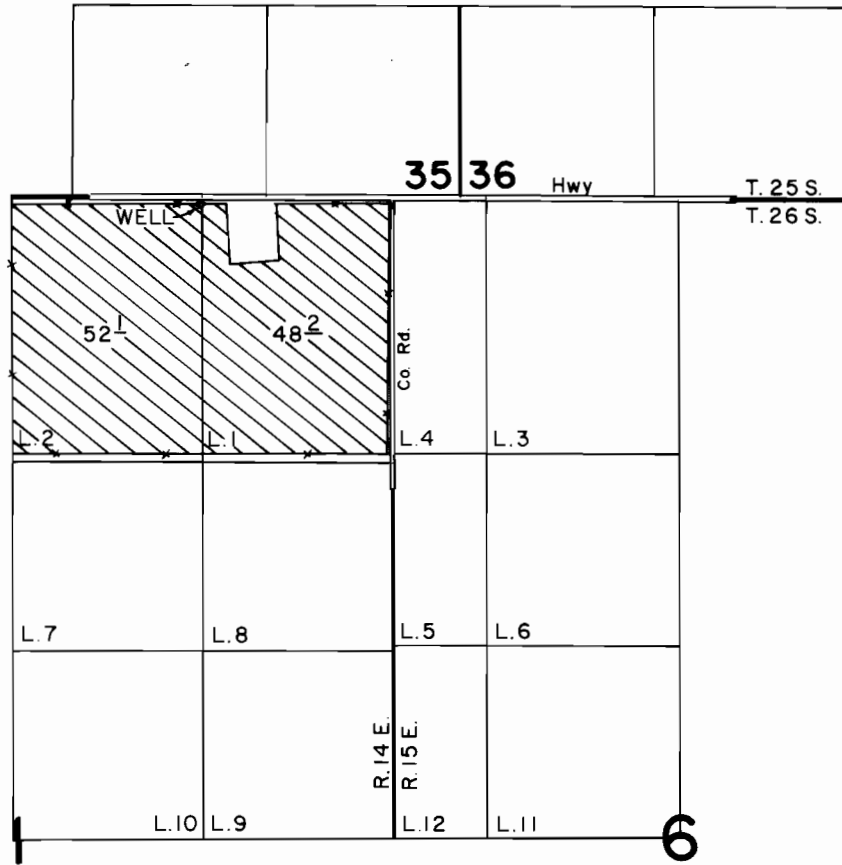

WELL LOC.: 40' S. & 1330' W. FROM N.E. CORNER SECTION 1

SCALE: 1" = 1320'

## FINAL PROOF SURVEY UNDER

Application No. G-11375 Permit No. G-10708  
IN NAME OF

D. V. A.

Surveyed JULY 11, 1989, by B. W. BISHOP