


T. 23 S., R. 45 E., W.M.

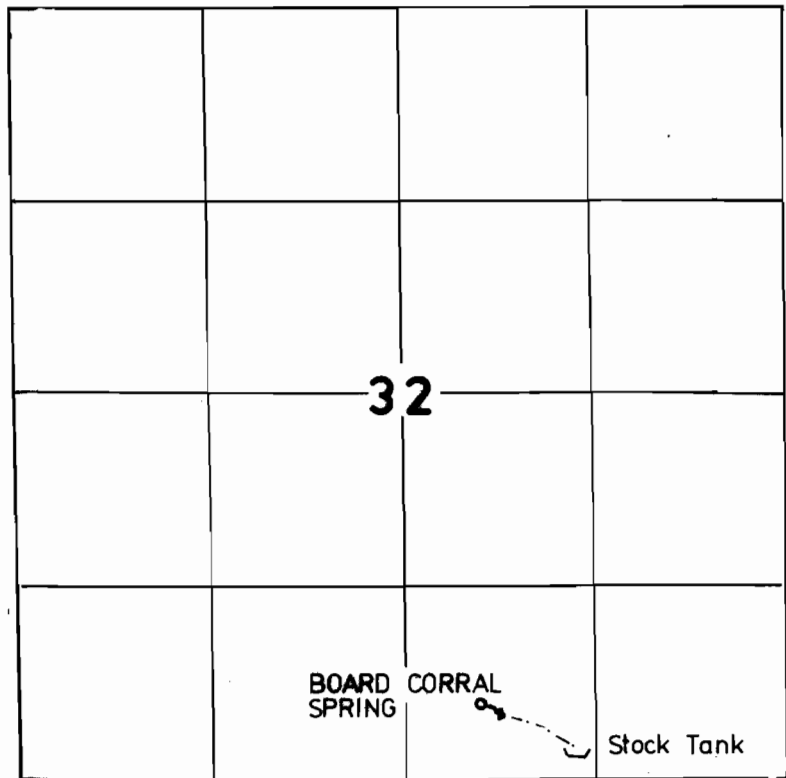

1" = 1320'

POD - 800' S. AND 520' E. FROM THE NW COR. OF THE
SW 1/4 SE 1/4.

FINAL PROOF SURVEY

UNDER

Application No. 67538 Permit No. 49146

IN NAME OF

DUNCAN D. MACKENZIE

Surveyed 8-25, 1993, by J. MILLER