T.2 S., R.10 E., W.M.

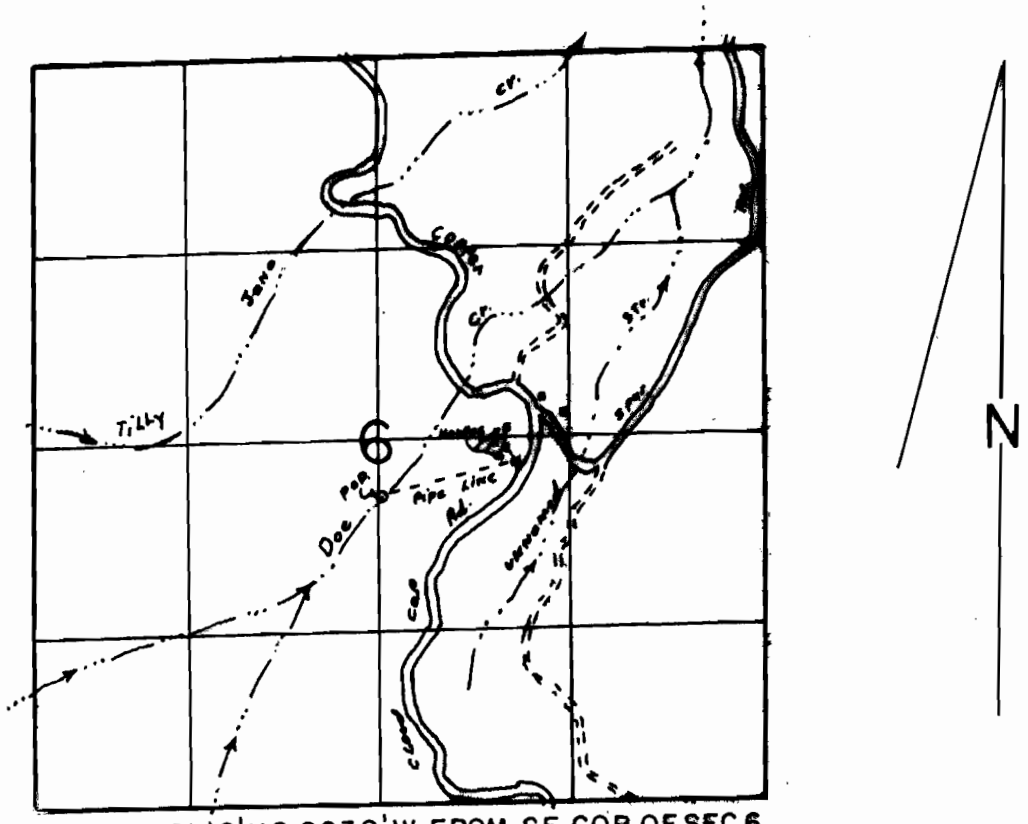

POD. LOC. 2140' N & 2630' W FROM SE COR. OF SEC 6.

SCALE: 1" = 1320'

FINAL PROOF SURVEY
UNDER

Application No. 56896 **Permit No.** 42777

IN NAME OF

KATHRYN E. SEE

Surveyed AUG. 21, 1995, **by** R.M. SUTTERFIELD

SURVEY ON 7 1/2 QUAD DOE CREEK 11/1/95 R.M.S