


T. 1 S., R. 32 E., W.M.

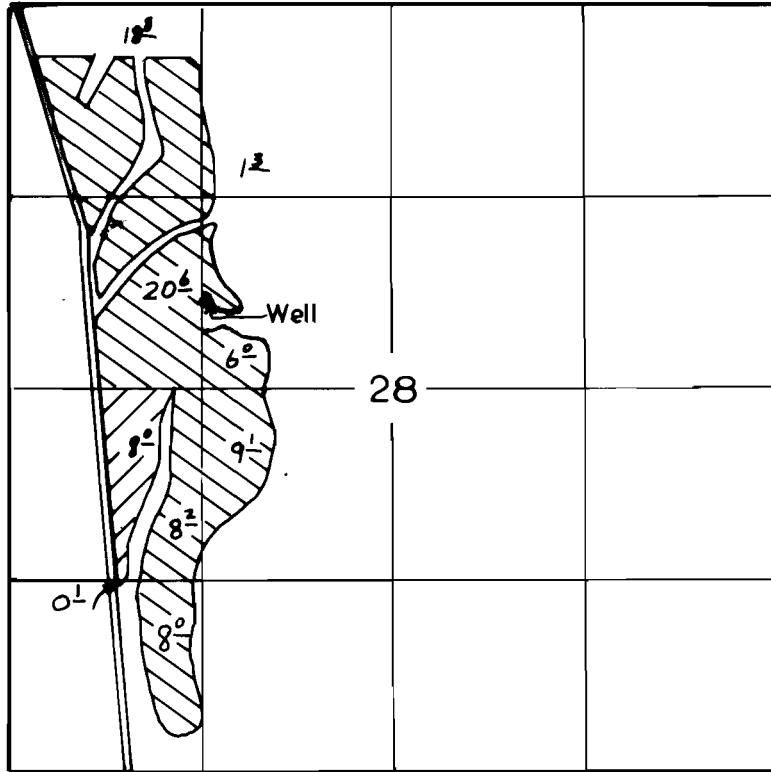

WELL - 610' N. AND 1350' E. FROM W 1/4 COR. SEC. 28.



PRIMARY



SUPPLEMENTAL

FINAL PROOF SURVEY

UNDER

Application No. ~~G-2448~~ ^{G-2117} Permit No. G 7968
IN NAME OF

THOMAS E. RUGG

Surveyed 10-3, 1990, by K. KEMP

3-28-06 J.W.G.
12-22-93 J.M. 15A7