


T. 2N., R. 30E., W. M.

FINAL PROOF SURVEY
UNDER

APPL. 49008
52447
58563

PER. 41362
39444
44220

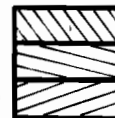

IN NAME OF


LEWIS LIVESTOCK COMPANY, INC.

Surveyed 2-17-1978, by R. BARWIN

4-26-84

V. CHURCH

Div. Pt. 4 Loc: 780 N. & 1550 E From W 1/4 Cor. Sec. 12
Div. Pt. 3 Loc: 250 S. & 960 E. From W 1/4 Cor. Sec. 12
Div. Pt. 1 Loc: 1300 N. & 1050 W. From S 1/4 Cor. Sec. 2

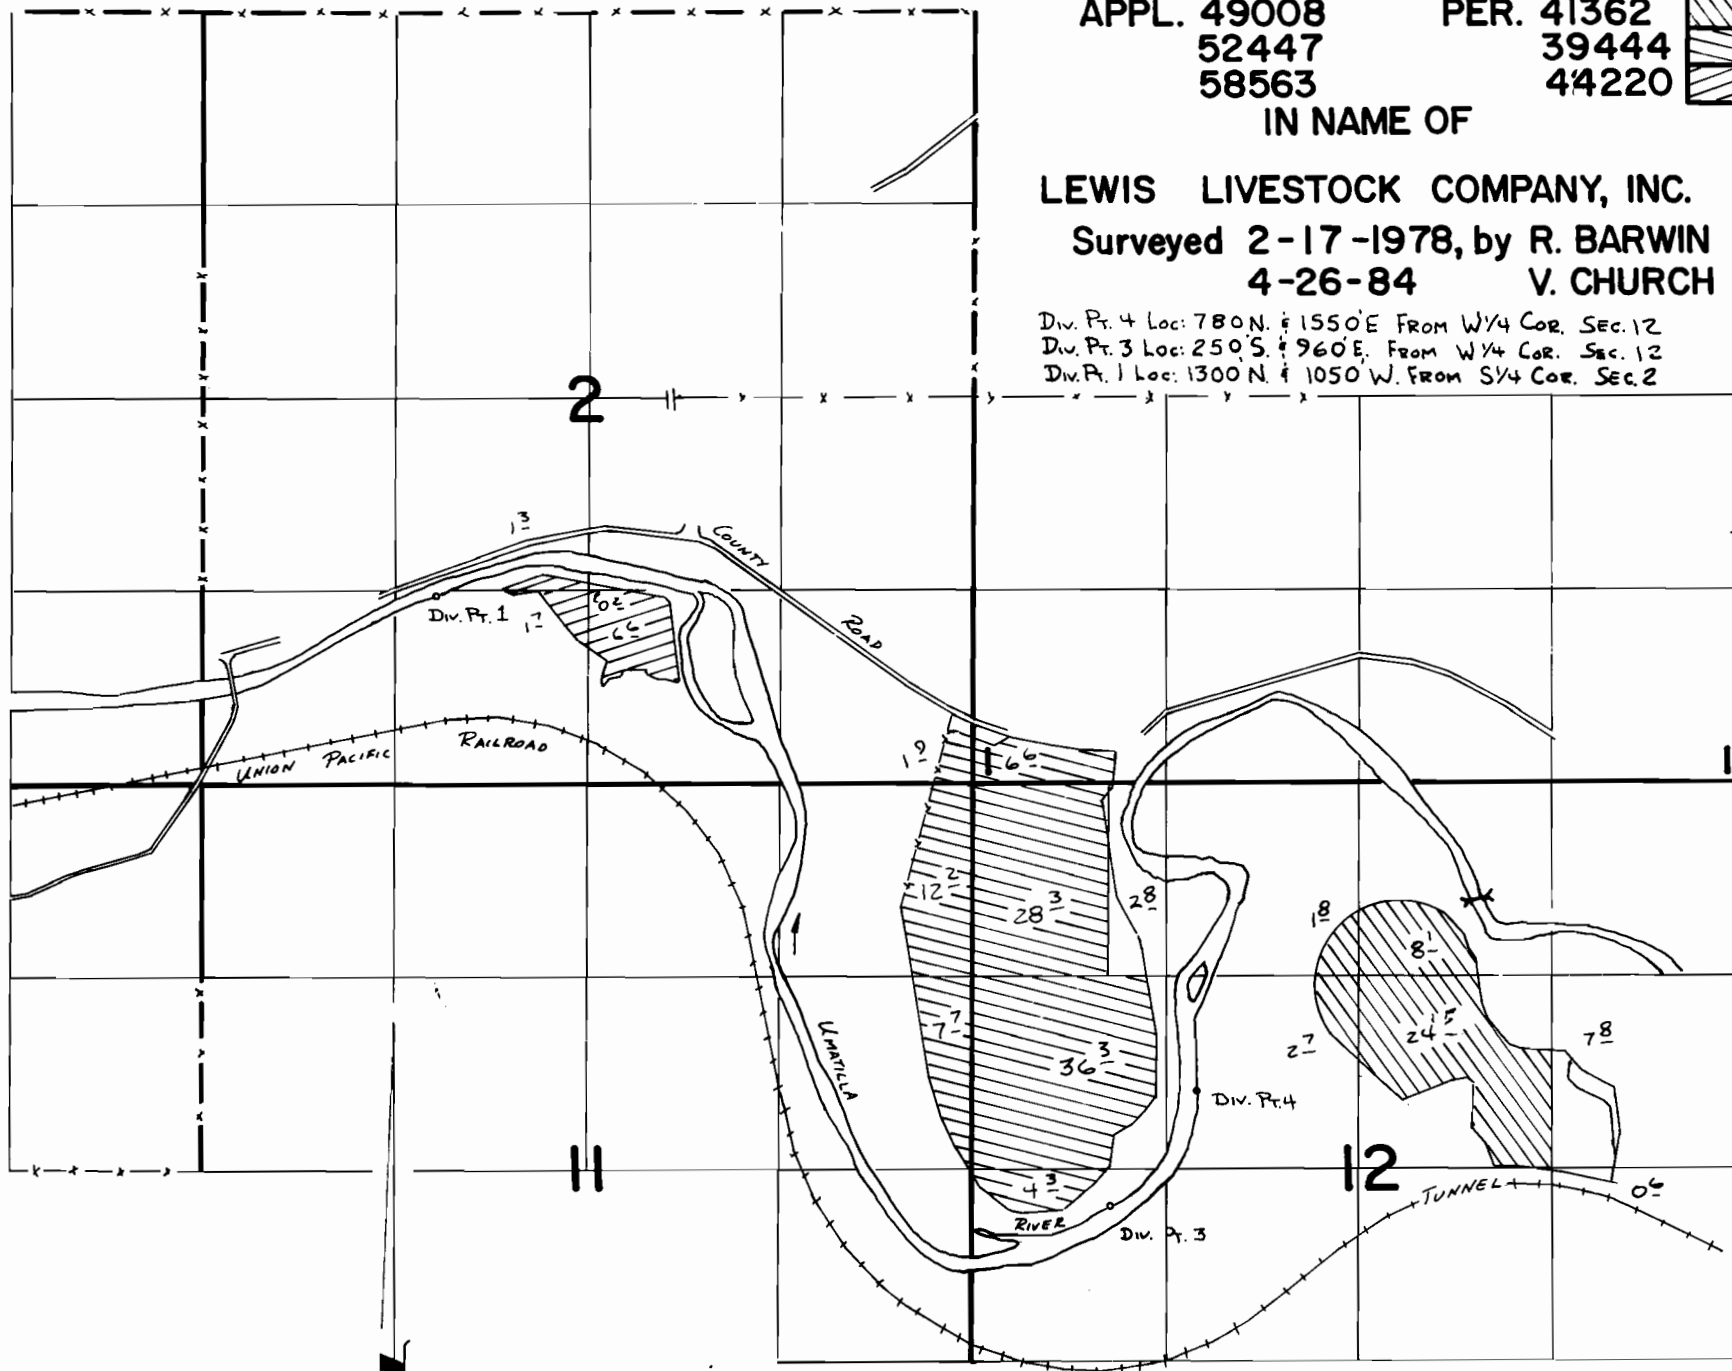

SCALE: 1" = 1320'

NE-2P-184

119L 118L 10A-12

REV. 3-30-06 JWG
REV. 3-6-86 VCC