
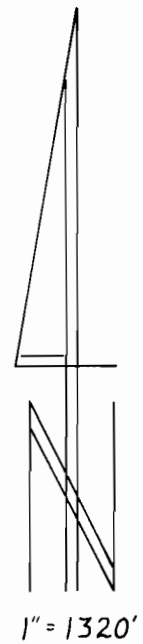


T. 15 & 16 S., R. 6 W., W.M.

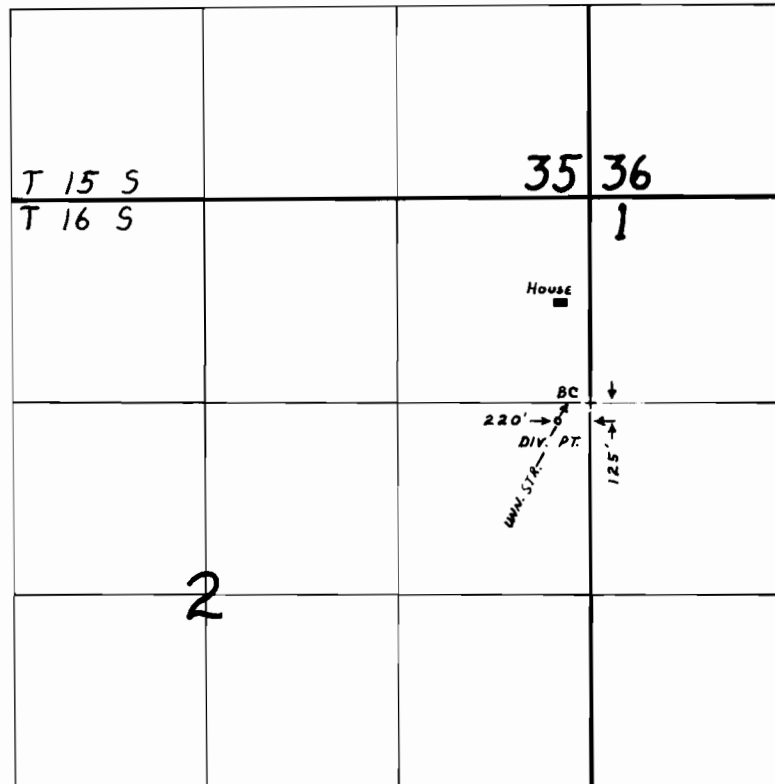

FINAL PROOF SURVEY

UNDER

Application No. 58960 Permit No. 44601
IN NAME OF

ROBERT E. ALVORD JR.

Surveyed MAY 21, 1992, by R.W.Klassen