


T. 4 N., R. 28 E., W.M.

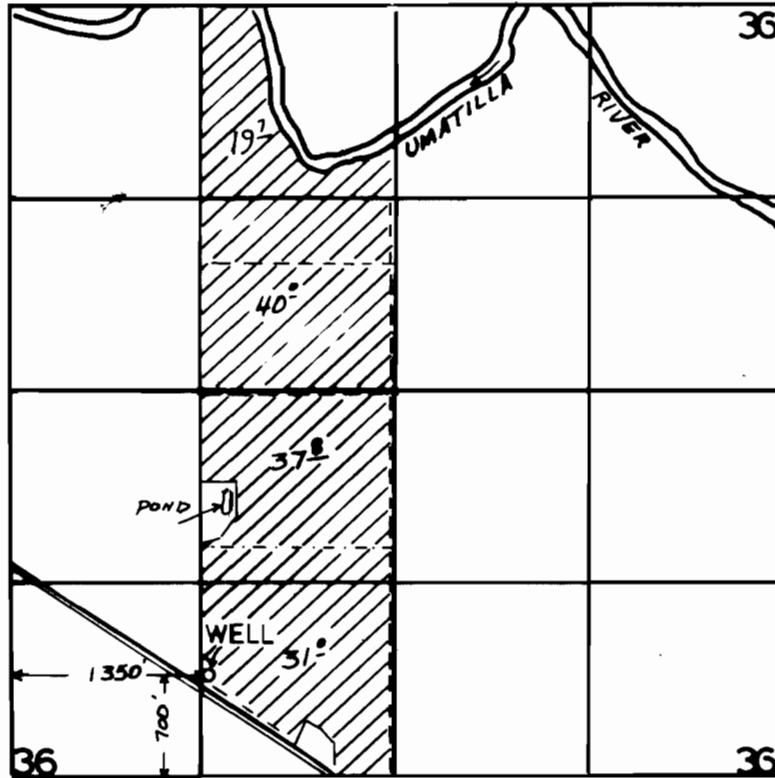

1" = 1320'

FINAL PROOF SURVEY
UNDER

Application No. G-8574 Permit No. G-7913
IN NAME OF

FRANK MUELLER

Surveyed AUGUST 22, 1991, by L. Miller