


T. 4 N., R. 25 E., W.M.

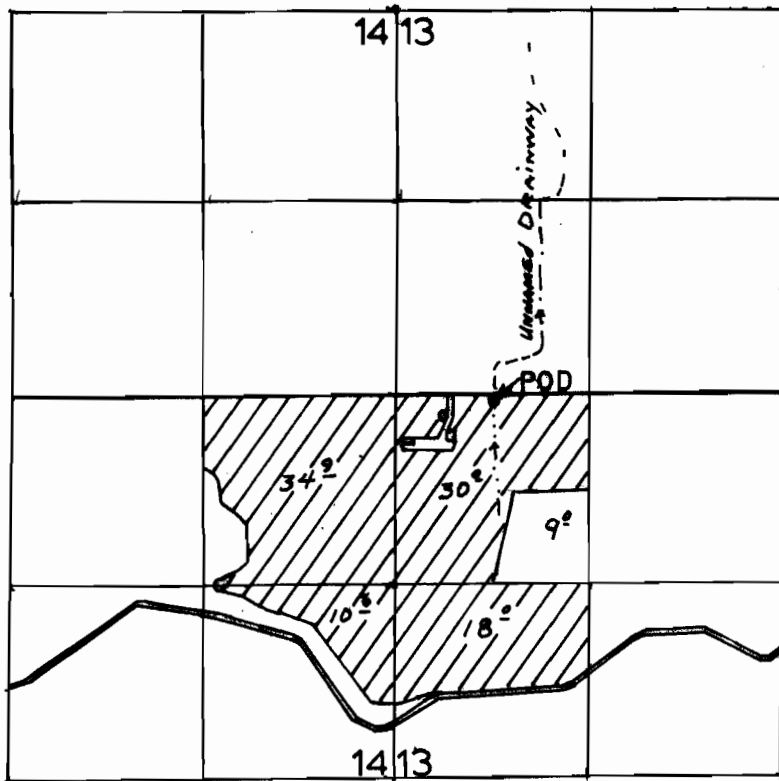

POD - 50' SOUTH AND 700' EAST FROM THE W. 1/4 COR. SECTION 13.

RECEIVED

JUL 31 1998

WATER RESOURCES DEPT.
SALEM, OREGON

FINAL PROOF SURVEY
UNDER

Application No. 68481 Permit No. 49571
IN NAME OF

GRIEB FARMS, INC.

Surveyed 5-19, 1994, by I. MILLER