

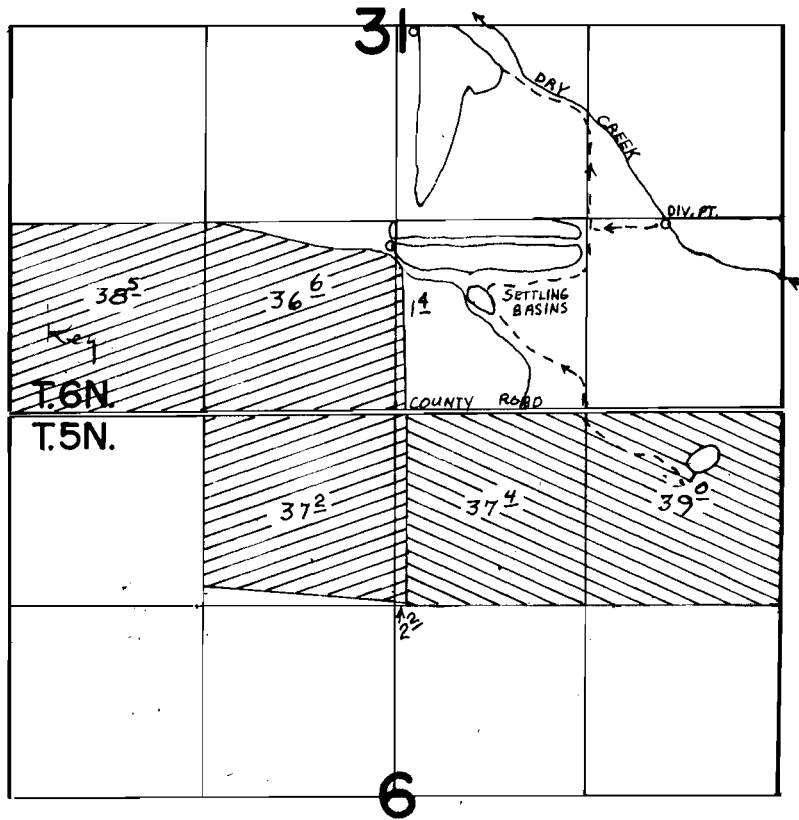


T.5&6N., R.35E., W. M.

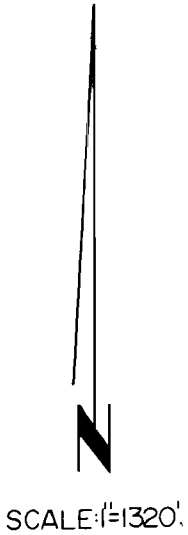

T.5N.R.35E.W.M.

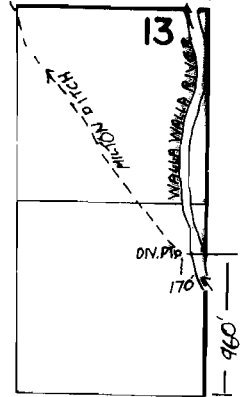

PRIMARY



SUPPLEMENTAL
TO CERT. 28272

FINAL PROOF SURVEY UNDER

Application No. 55137..... Permit No. 41599.....
IN NAME OF

KEY-WALLACE

Surveyed FEB. 1..... 1984., by V.L. CHURCH.....