


T.5S., R.11E., W.M.

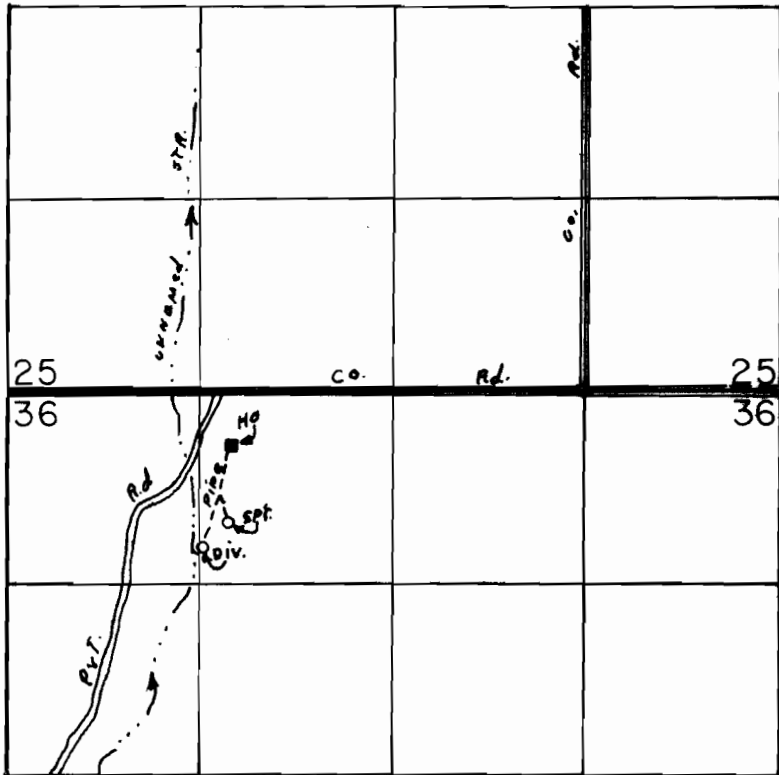

SPR. LOC: 940' S & 1480' E AND DIV. LOC: 1030' S & 1350' E ALL FROM
NW COR. OF SEC 36.

SCALE: 1" = 1320'

**FINAL PROOF SURVEY
UNDER**

Application No. 56583 Permit No. 42416
IN NAME OF

MURLE M. STADLER

Surveyed SEPT. 14, 1995., by R.M. SUTTERFIELD.