


RECEIVED

MAR 10 1987

WATER RESOURCES DEPT.
SALEM, OREGON

T.5S.R.10W.W.M.

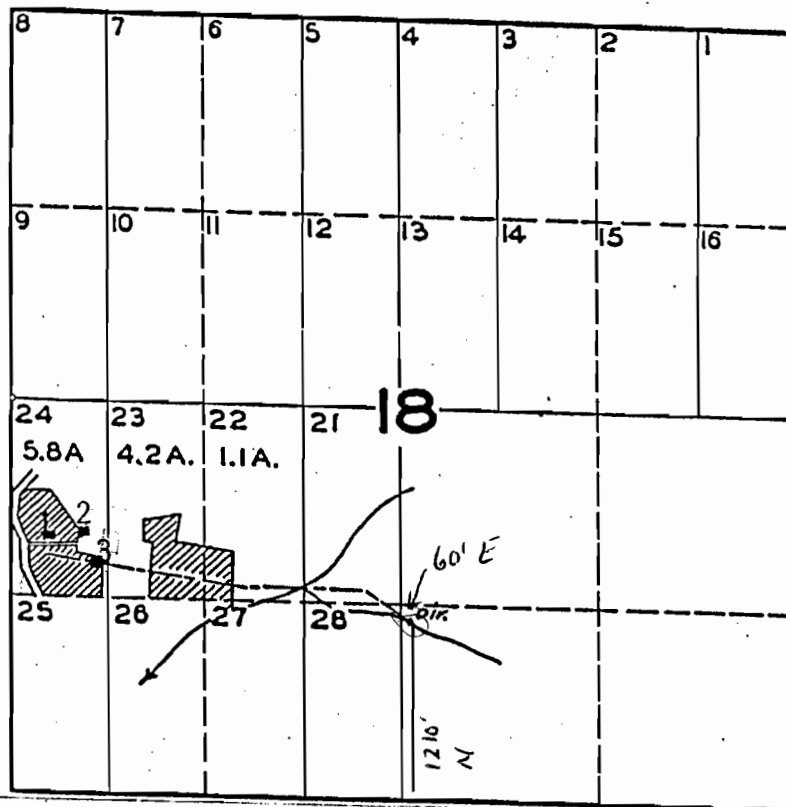

S¹/₄

Application #68843

Goodwin and Katharine Harding

1. House
2. Art Studio
3. Barn

Application No. 68843
Permit No. 50002