


T.1N.&1S.,R.9&10E.,W.M.

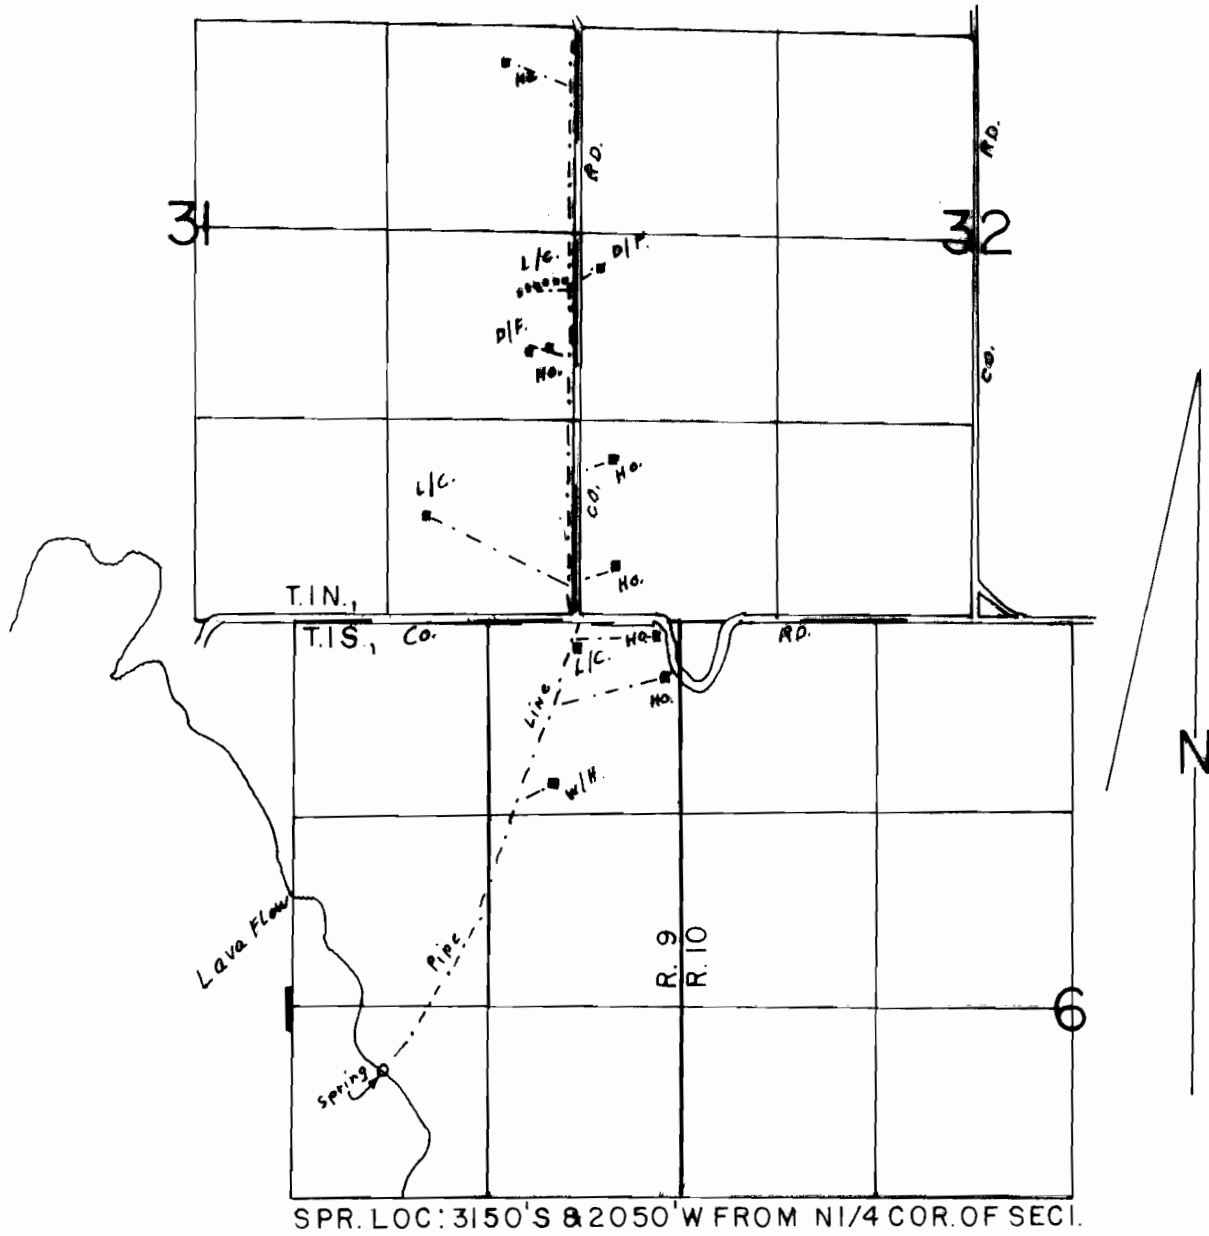

SCALE: 1"=1320'

FINAL PROOF SURVEY
UNDER

Application No. 64532. Permit No. 48401....
IN NAME OF

PAUL H. KLINDT, BOB MCISAAC & PAT PETTEYS.

Surveyed APRIL 23 1996, by R.M. SUTTERFIELD.