


**T. 2 N., R. 10. E, W.M.**

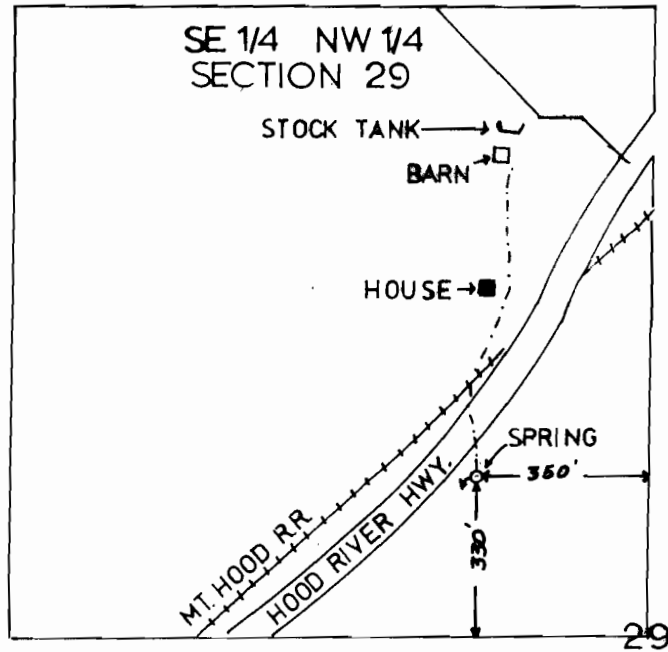

1" = 400'

**FINAL PROOF SURVEY**  
UNDER

Application No. 58880 Permit No. 45434  
IN NAME OF

WALTER M. FARGHER, JR.

Surveyed SEPTEMBER 30, 1993, by J. MILLER