


T.2N.,R.10E.,W.M.

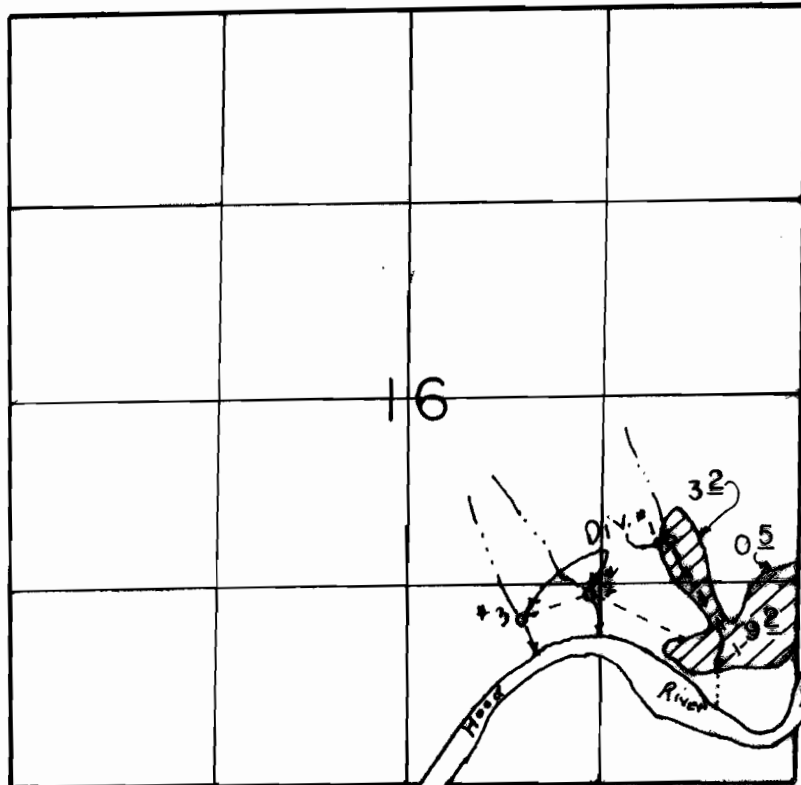

DIV. PT. 1 LOC: 1680' N & 870' W. DIV. PT. 2 LOC: 1300' N & 1430' W  
DIV. PT. 3 LOC: 1140' N & 1900' W. ALL FROM SE COR. OF SEC 16.

SCALE: 1" = 1320'

**FINAL PROOF SURVEY**  
**UNDER**

Application No. 64587. Permit No. 47436...  
**IN NAME OF**

..... HORACE ARTHUR DAUM .....

Surveyed AUG 24 19 95, by R.M. SUTTERFIELD