
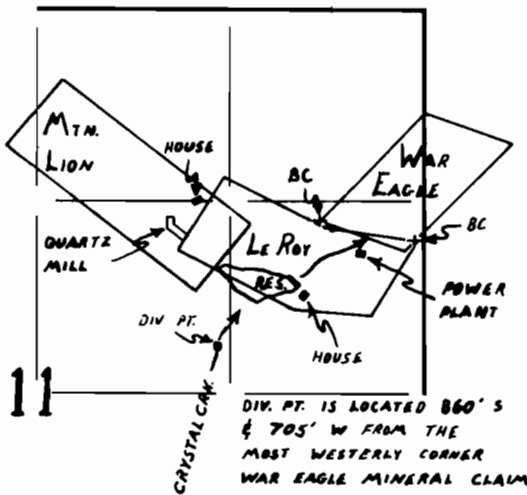


T. 23 S., R. 1 E., W.M.

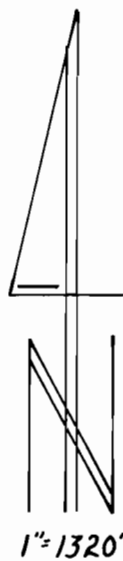

FINAL PROOF SURVEY
UNDER

Application No. R-55705 & 55706 Permit No. R-6757 & 42610
IN NAME OF

GUY E. LEABO, DBA FAIRVIEW CREEK MINE & TIMBER COMPANY

Surveyed MAY 18, 1992, by R.W. Klassen