
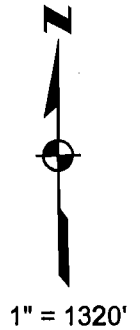


T. 14 S., R. 11 E., W.M.

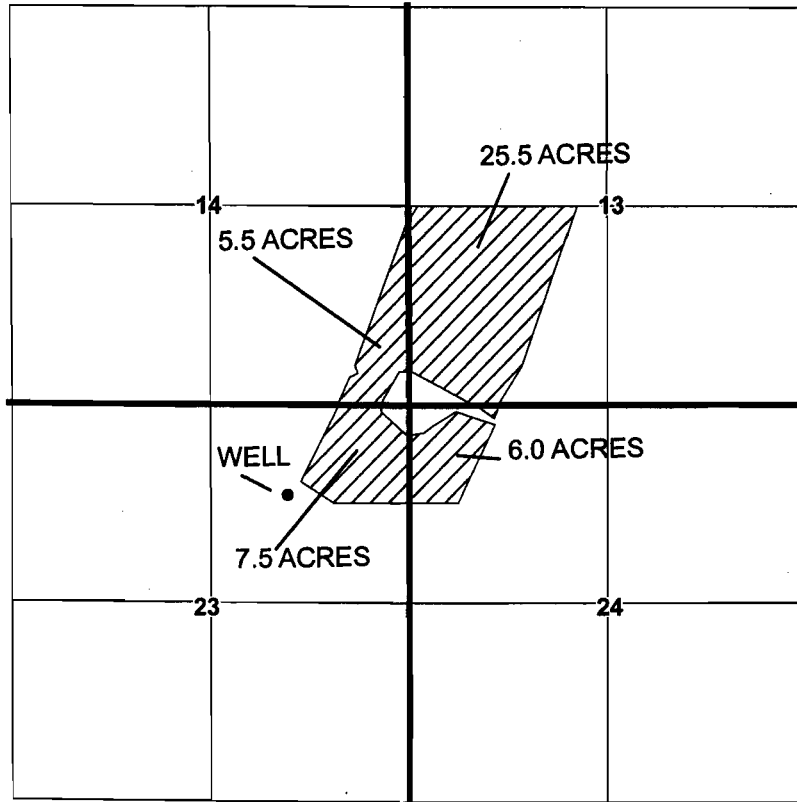

WELL LOCATION: 600 FEET SOUTH AND 820 FEET WEST FROM NE CORNER OF SECTION 23

FINAL PROOF SURVEY

UNDER

APPLICATION NO. G-10444

PERMIT NO. G-9841

MAP BASED ON 3111 MAP FOR SQUAW CREEK IRRIGATION DISTRICT