

Application No. 60182


Permit No. 44961

RECEIVED

T.7S. R.1E. W.M.

MAY 2 1980

WATER RESOURCES DIVISION  

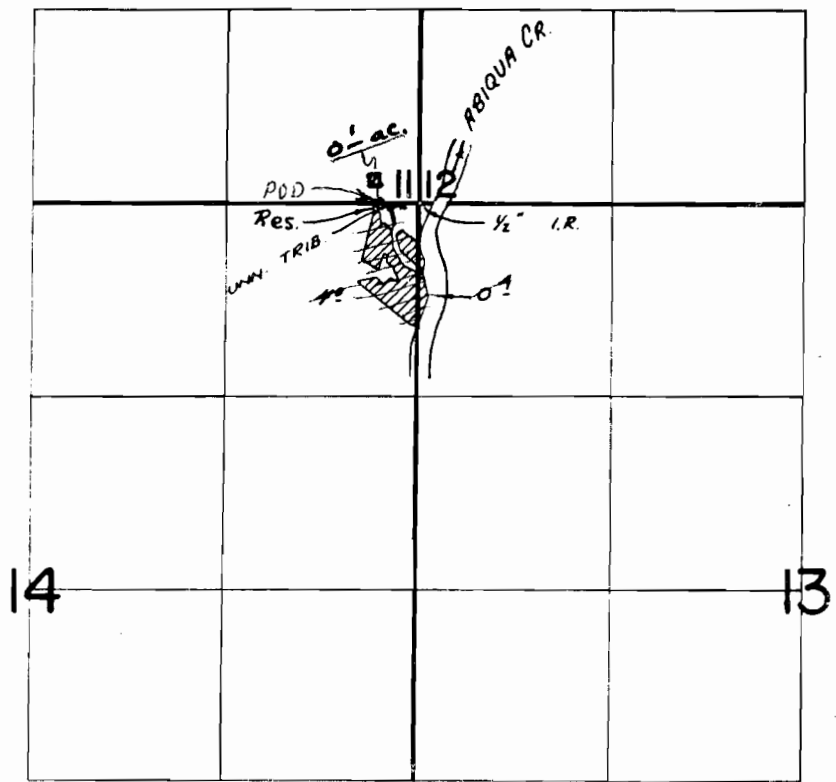

Res. Loc. ~~20~~ 190' S From NE Cor. Sec. 14  
10' N 250' W

~~FINAL PROOF SURVEY~~  
UNDER

THIS MAP PREPARED BY: Don Buell  
COMPILED, CALCULATED, FURNISHED, BY  
THE SURVEYOR

Application No. ~~40553~~ 40554 Permit No. ~~30272~~ 30272  
IN NAME OF

~~ELBERT MANOR~~

Surveyed July 5, 1973, by R.G. Mucken