


T. 7 S., R. 46 E., W.M.


RECEIVED

FEB 2 1998

WATER RESOURCES DEPT
SALEM OREGON

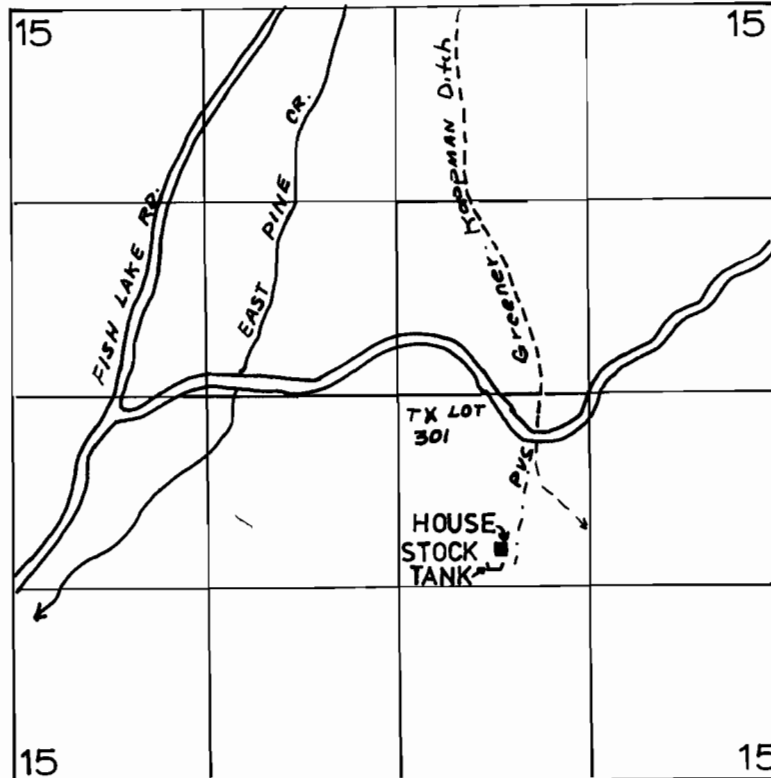

NE 1/4 SECTION 10

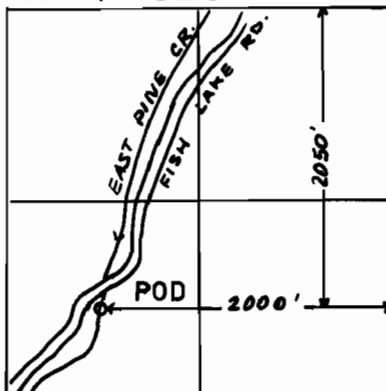

FINAL PROOF SURVEY

UNDER

Application No. 59548 Permit No. 45215
IN NAME OF

MARY Y. BENNETT & ESTATE OF EARLIN S. BENNETT, SR.

Surveyed 10-22, 1991, by J. MILLER