


T. 8 S., R. 44 E., W.M.

RECEIVED
MAY 19 1998
WATER RESOURCES DEPT
SALEM, OREGON

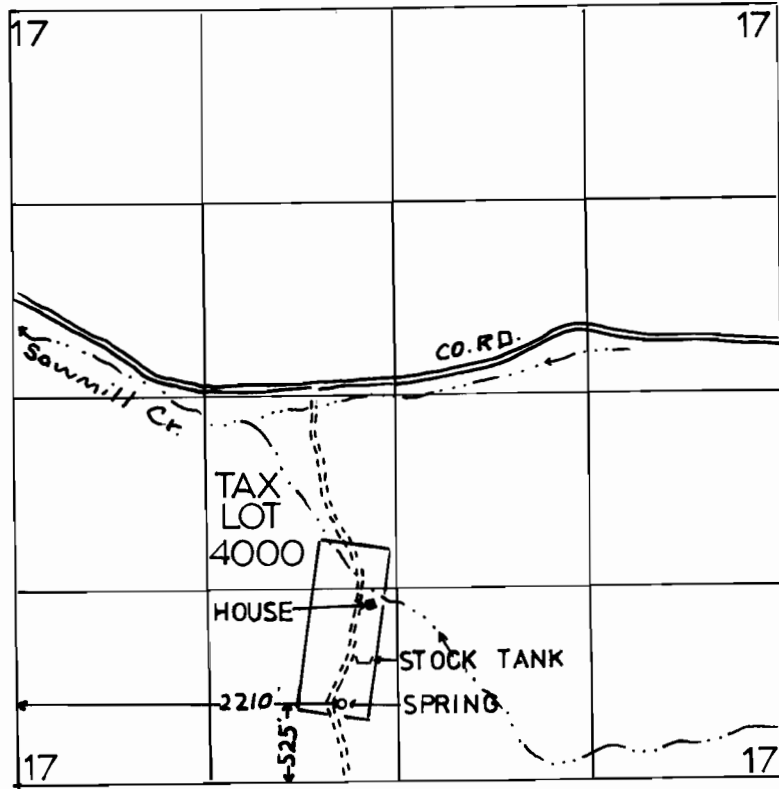

FINAL PROOF SURVEY

UNDER

Application No. 61631 Permit No. 46700

IN NAME OF

PERRY D. & MICHELE A. POWELL

Surveyed 5-13, 1992, by J. MILLER