


1" = 400'

FINAL PROOF SURVEY
 UNDER
 Application No. 64793 Permit No. 47364
 IN NAME OF
JERRY W. HOWARD
 Surveyed Nov. 5, 1991, by R. W. KLASSEN

SEE MAP NO. 8 6 28

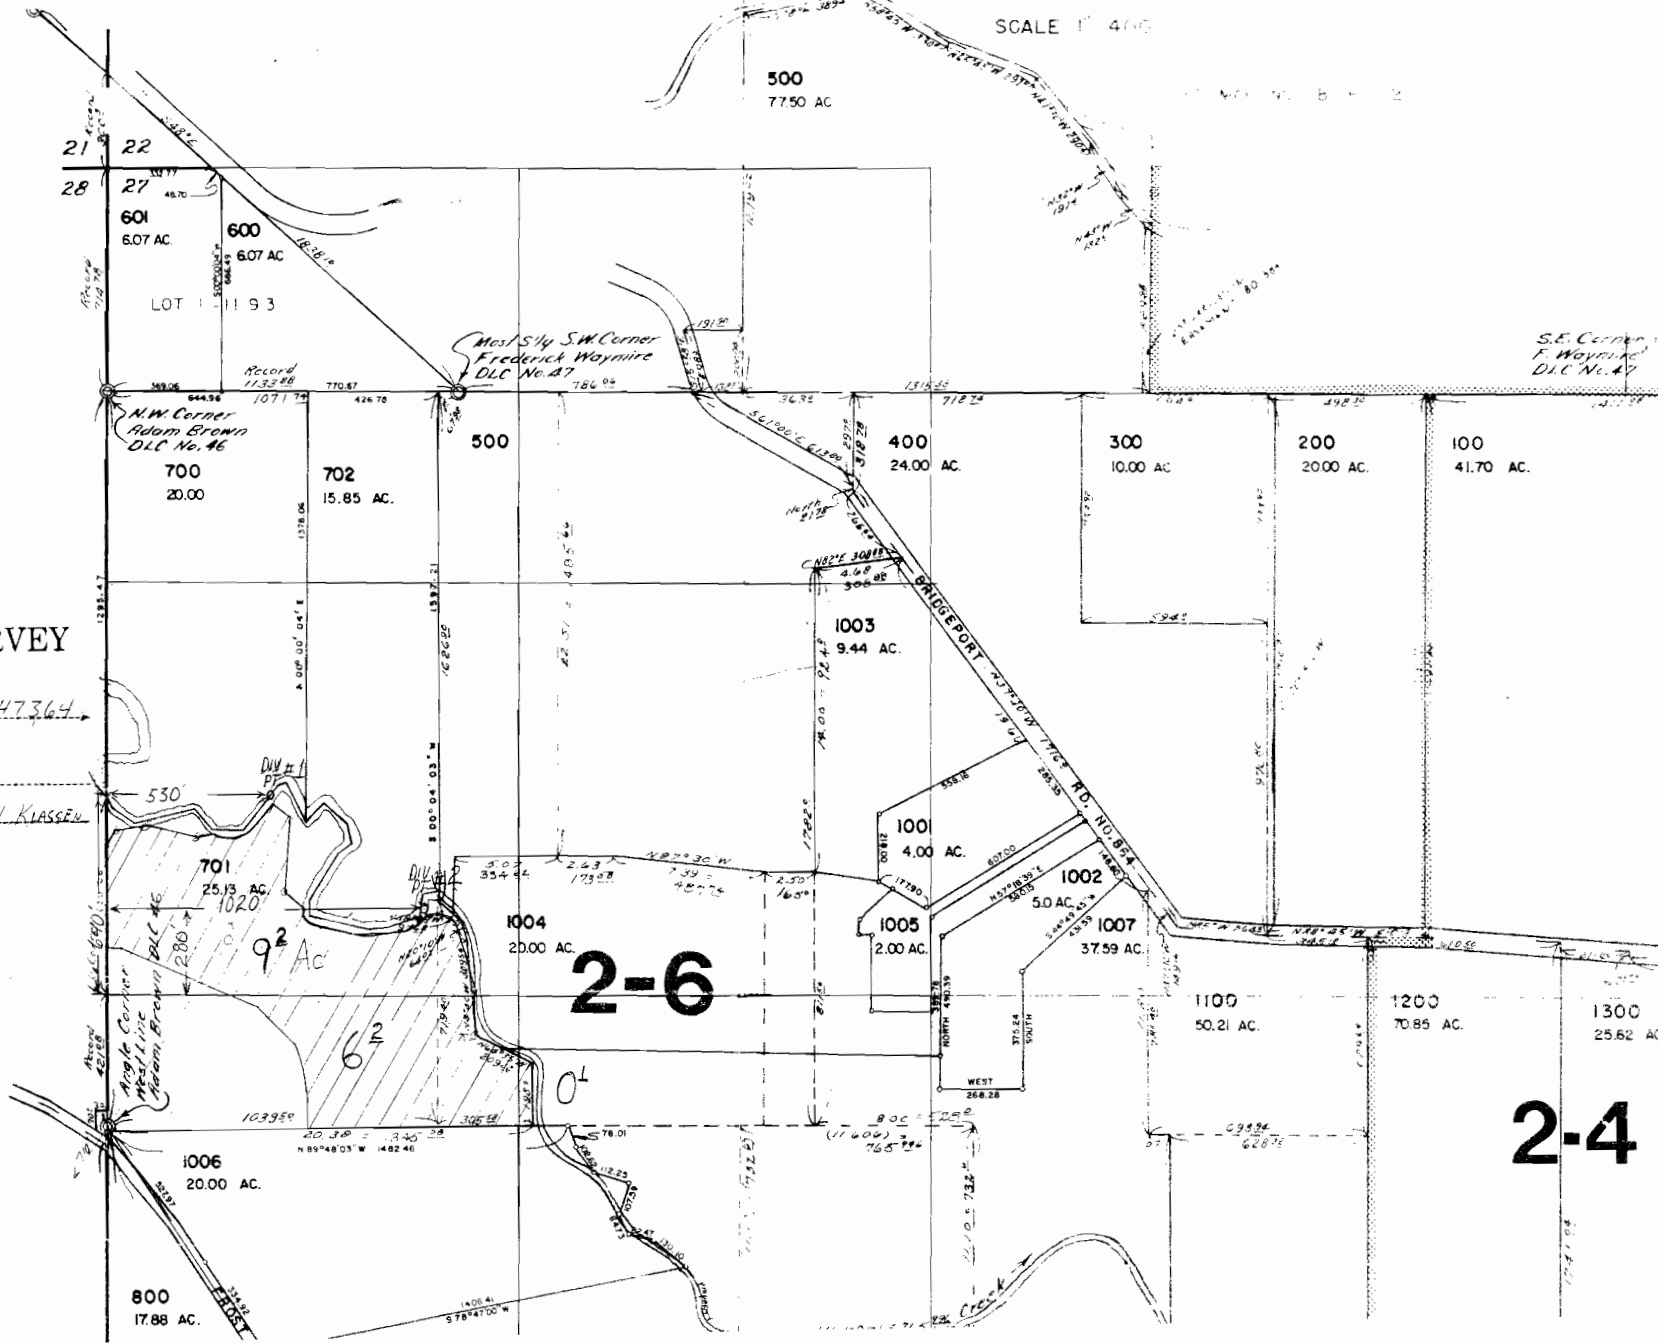

2-4