


T. 11 S., R. 39 E., W.M.

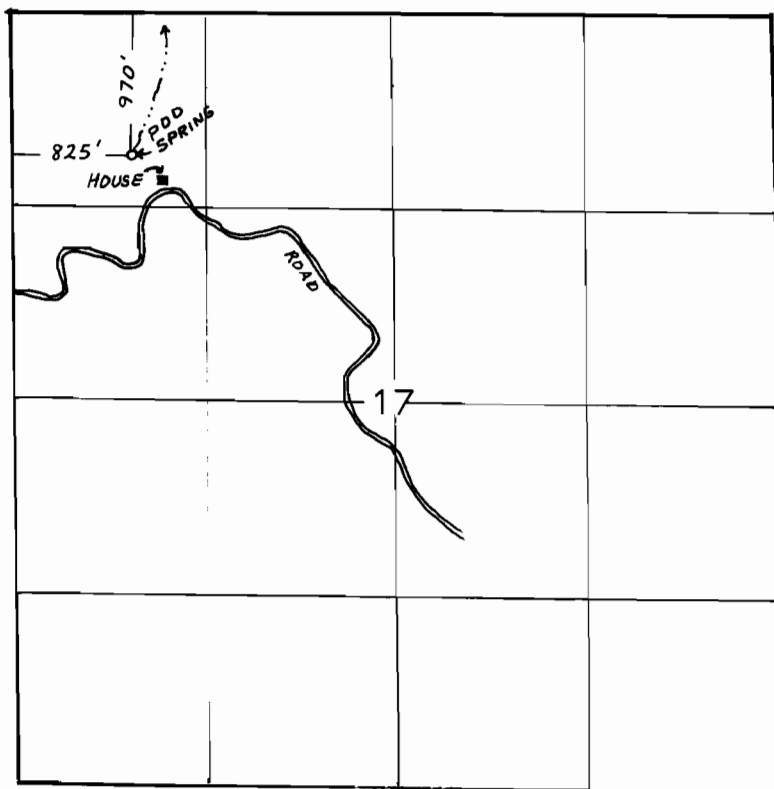

1"= 1320'

FINAL PROOF SURVEY

UNDER

Application No. 57571 Permit No. 43616
IN NAME OF

RICHARD TOUBEAUX

Surveyed 5-8, 1992, by J. MILLER